

# CERTIFIED RECORD OF LAND CORNER MONUMENTATION

## History of original corner establishment:

Original survey done by William R. Graden under contract No.409 dated March 1882.

Set a basalt stone 16X8X7 ins 11ins in the ground for  $\frac{1}{4}$ sec cor marked  $\frac{1}{4}$  on W. face from which

A fir 10 ins diam bears S35<sup>0</sup>E 62 Lks dist marked  $\frac{1}{4}$  S BT

A fir 20 ins diam bears N75<sup>0</sup>W 41 Lks dist marked  $\frac{1}{4}$  S BT


An aluminum cap was set by James Hanley in 1975

## Description of corner evidence found:

At the corner I found that the Aluminum cap set by James Hanley had been run over by a cat and destroyed. The pipe was still in the ground. I also found a stone 16" X 8" X 7" with a faint  $\frac{1}{4}$  marked on it buried in the hole.

There is nothing remaining of the S35<sup>0</sup>E bearing tree.

The N75<sup>0</sup>W is down and rotted in the proper location with faint scribing.

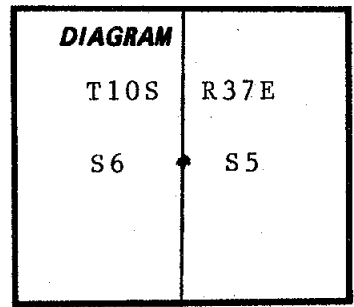

## Description of monument and accessories I established to perpetuate the original location of this corner:

I replaced the pipe and cap that had been set by James Hanley and had been destroyed with a 2 $\frac{1}{2}$ " X 32" brass capped steel pipe set 26" in the ground in a mound of stone from which

A 12" Ponderosa pine bears N53<sup>0</sup>E 10.96 ft. marked  $\frac{1}{4}$  S 5 BT Nail in N. base.

A 12" Ponderosa Pine bears S15<sup>0</sup>W 16.78 ft. marked  $\frac{1}{4}$  S 6 BT Nail in E. base.

Bearings taken with a staff compass declination 18 $\frac{1}{2}$ E. per 1980 Isogonic chart.

Distances pulled to 60d nails with a brass washer marked O.R.L.S.1898 set in side center of bearing trees.

Monument stamped:

T10S  
R  $\frac{1}{4}$  COR  
37  
E 6 5  
1982

O.R.L.S. 1898



Office of.....Surveyor..... County of....Baker.....

State of.....Oregon....., I hereby certify that the within instrument was filed in this office

for record on the..... day of....., 19.....

..... by .....  
(COUNTY OFFICIAL) (DEPUTY)

Form R6-7100-57 (9/71)

FILED July 19, 1982  
BAKER COUNTY SURVEYOR  
SURVEY NO. 10-37-15

☆ GPO—798-276

C-05