

CERTIFIED RECORD OF LAND CORNER MONUMENTATION

History of original corner establishment:

Corner established in 1882, by William R. Gordon, Under General Land Office contract No. 409. Surveyor Generals Notes state:
Set a basalt stone 12"x8"x5" 8" in the ground for $\frac{1}{4}$ section corner marked $\frac{1}{4}$ on N face.
From which:
A Pine 28" dia. bears N35°W, 27 lks dist., marked $\frac{1}{4}$ S BT.
A Pine 6" dia. bears S50°W, 54 lks dist., marked $\frac{1}{4}$ S BT.

DIAGRAM

T10S R37E
 $\frac{1}{4}$ $\frac{S5}{S8}$
1971
B.L.M.

CONTINUED ON ATTCHED SHEET

Description of corner evidence found:

Found brass cap monument stamped as shown on the diagram, firmly set in the ground with small stone mound North of pipe.

A steel post set alongside pipe.

From which:

Original bearing trees.

A Pine 19" dia. bears S60°W, (S50°W) 35.6 ft.

A " stump bears N32°W, (N35°W) 19.0 ft. (17.8)

Trees taken by BLM in 1971.

A Fir 14" dia. bears N17°E, (N57°E) 34.5 ft. (35.0)

A Pine 10" dia. bears S53°W, (S54 $\frac{1}{2}$ °W) 45.3 ft. (45.5)

Description of monument and accessories | established to perpetuate the

original location of this corner:



Maintained corner by wiring a warning sign to post, next to pipe.

Maintained bearing trees by nailing bearing tree signs above blaze where needed and warning signs to back of trees where needed.

Painted 6" red band around each tree.

Noted.

Corner monumented 8-19-83
Witnessed by Dan Martin

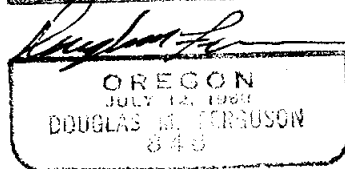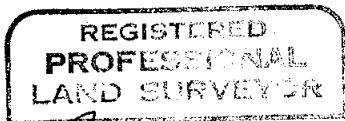

Office of..... County of.....
State of....., I hereby certify that the within instrument was filed in this office
for record on the..... day of....., 19.....
..... by
(COUNTY OFFICIAL) (DEPUTY)

Form R6-7100-57 (9/71)

FILED Nov. 17, 1983
BAKER COUNTY SURVEYOR
SURVEY NO. 10-37-24