

# CERTIFIED RECORD OF LAND CORNER MONUMENTATION

## History of original corner establishment:

Corner established in 1882 by William R. Groden, Under General Land Office Contract No. 409. Surveyor Generals Notes State:  
 Set a basalt stone 12x10x5", 8" in the ground for corner to sections 5, 6, 7, and 8 marked with 5 notches on S and E edges. From which:  
 A Fir 16" dia. bears N35°E, 36 lks dist. marked T10S R37E S5 BT.  
 A Tamarack 12" dia. bears S45°E, 12 lks dist. marked T10S R37E S8 BT.  
 A Pine 40" dia. bears S55°W, 80 lks dist. marked T10S R37E S7 BT.  
 A Fir 10" dia. bears N33°W, 36 lks dist. marked T10S R37E S6 BT.

## DIAGRAM

T10S R37E  
 S6 | S5  
 S7 | S8  
 1971  
 B.L.M.

Continued on attached sheet;

## Description of corner evidence found:

Found brass cap monument stamped as shown on the diagram, firmly set in the ground in good condition with a steel post set alongside.


From which:

A Tamarack 20" dia. original tree, with healed over blaze, bears S45°E, 9 ft. (7.9) A Fir 25" dia. original tree, with healed over blaze bears N40°E, (N35°E) 24.0 ft. (23.8) A Fir 30" original tree with healed over blaze bears N30°W, (N33°W) 24.0 ft.  
 New bearing trees taken by B.L.M. A Tamarack 12" dia. (13") bears S58°E, (S54°) 25.9 ft. (26.0) B.L.M. notes should read S54°E, 39½ lks dist. mkd. T10S R37E S8 BT. tree is scribed properly  
 A Fir 7" dia. bears S60°W, (S55°W) 34.5 ft. (35.6) Note ( ) indicate record measurment.

## Description of monument and accessories | established to perpetuate the original location of this corner:

Maintained corner by wiring a warning sign to the steel post set alongside pipe.  
 I scribed a new bearing tree, A Pine 9" dia. bears N90°E, 43.3 ft. scribed T10S R37E S5 BT.  
 Nailed brass washers stamped PLS848, bearing tree and warning signs to each tree.  
 Painted 6" red band around each tree. Nailed bearing tree signs above blaze where needed and warning signs to back of trees as needed on the trees noted above. Painted 6" red band around each tree. The original tree in the N.W. quadrant is in good condition, thus providing a full compliment of accessories.

Corner monumented 8-19-83  
 Witnessed by Dan Martin

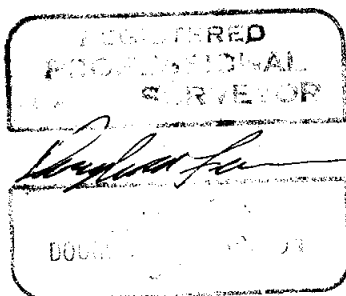

Office of..... County of.....  
 State of....., I hereby certify that the within instrument was filed in this office  
 for record on the..... day of....., 19.....

(COUNTY OFFICIAL)

by (DEPUTY)

Form R6-7100-57 (9/71)

FILED Nov. 17, 1983

☆ GPO—798-276

BAKER COUNTY SURVEYOR

SURVEY NO. 10-37-26