

CERTIFIED RECORD OF LAND CORNER MONUMENTATION

History of original corner establishment:

Corner not previously established.

DIAGRAM

T10S R37E
C $\frac{1}{4}$
S 5
1983
PLS848

Description of corner evidence found:

N/A

Description of monument and accessories I established to perpetuate the original location of this corner:

Set a 30"x2 $\frac{1}{2}$ " aluminum pipe with a 2 $\frac{1}{2}$ " aluminum cap stamped as shown in diagram. Set 10" in the ground and raised a mound of stone and earth around the pipe.

From which:



A Tamarack 9" dia. bears N69°W, 17.4 ft. scribed C $\frac{1}{4}$ S5 BT.

A Fir 9" dia. bears S45°E, 40.5 ft. scribed C $\frac{1}{4}$ S5 BT.

Set steel posts with warning and boundary signs East 2.5 ft. and North 2.5 ft.

Nailed brass washers stamped PLS848, bearing tree and warning signs to each tree.

Painted 6" red band around each tree.

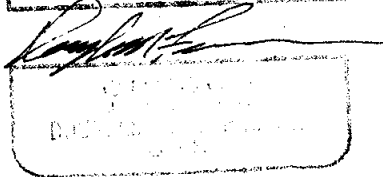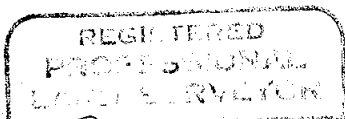

Corner monumented 8-19-83

Witnessed by Dan Martin

Office of..... County of.....

State of....., I hereby certify that the within instrument was filed in this office for record on the..... day of....., 19.....

..... by
(COUNTY OFFICIAL) (DEPUTY)

Form R6-7100-57 (9/71)

FILED Nov. 17, 1983
BAKER COUNTY SURVEYOR
SURVEY NO. 10-37-27

☆ GPO—798-276