

CERTIFIED RECORD OF LAND CORNER MONUMENTATION

History of original corner establishment:

Corner was established by William R. Gradon, US Deputy Surveyor, during the original survey Contract No. 409 dated March, 1882.

"Set a post, 4 ft. long, 4 ins. square, 24 ins in the ground, for cor. to secs 22,23,26&27, marked with 2 notches on S and E edges, from which:
A pine 16 ins diam. bears N40°E 36 lks dist, marked T10S R37E S23 BT.
A pine 18 ins diam. bears S25°E, 8 lks dist, marked T10S R37E S26 BT.
A fir 18 ins diam. bears S40°W, 58 lks dist, marked T10S R37E S27 BT.
A tamarack 14 ins diam. bears N40°W, 52 lks dist, marked T10S R37E S22 BT."

In 1971 the Bureau of Land Management monumented the corner as follows:

"The cor. of secs. 22, 23, 26 and 27, perpetuated by person(s) unknown, monumented with an iron pipe, 2 1/2 ins. diam., projecting 8 ins. above ground, from which the remains of the original bearing trees:

A pine stump, 18 ins. diam., bears N44°E, 36 lks. dist., with scribe marks BT visible on open blaze. (Record, N40°E)

A pine stump, 20 ins. diam., bears S25°E, 8 lks. dist., with scribe marks BT visible on open blaze.

A root hole, bears S40°W, 58 lks. dist., with a down fir alongside, size indeterminate, no marks visible.

A western larch snag, 16 ins. diam., bears N40°W, 58 lks. dist., with scribe marks T10S R37E S22 BT visible on open blaze.

At the corner point set an iron post 28 ins. long, 2 1/2 ins. diam., 24 ins. in the ground, with brass cap mkd. as shown on diagram,

from which new bearing trees:

A ponderosa pine, 11 ins. diam., bears N7°E, 73 1/2 lks. dist., mkd. T10S R37E S23 BT.

A western larch, 12 ins. diam., bears S68°E, 115 lks. dist., mkd. T10S R37E S26 BT.

A western larch, 11 ins. diam., bears S14°W, 33 lks. dist., mkd. T10S R37E S27 BT.

A ponderosa pine, 7 ins. diam., bears N38°W, 46 lks. dist., mkd T10S R37E S22 BT.

Bury a basalt stone, 4 x 4 x 3 ins., with an X chiseled on W. face and reset iron pipe alongside iron post."

Description of corner evidence found:

Found 1971 BLM brass cap in good condition, stamped as shown on diagram, with steel post set alongside, from which:

A 14" Western Larch, bears S68°E, 115 lks., with blaze healed over.

A 13" Western Larch, bears S14°W, 33 lks., with blaze healed over.

Description of monument and accessories I established to perpetuate the original location of this corner:

Maintained corner by attaching "Land Survey Monument" signs to steel post and bearing trees as needed, painting 6" wide red bands around bearing trees, and making new accessories:

An 11" Western Larch, bears N61°30'W, 25.19 ft., scribed "T10S R37E S22 BT"

A 9" Western Larch, bears N7°10'E, 37.76 ft., scribed "T10S R37E S23 BT"

I, Leland Lee Myers, 587 E Auburn Street, PO Box 98, Sumpter, OR 97877, do hereby certify that on November 19, 1994, I maintained the corner as herein described.

FILED IN THE OFFICE OF THE BAKER COUNTY SURVEYOR THIS

7 DAY OF Feb, 1995.

10-37-62

Baker County Surveyor

Client: Lyle Defrees & US Forest Service

DIAGRAM

T10S R37E

S22


S23

S27

S26

1971

BLM

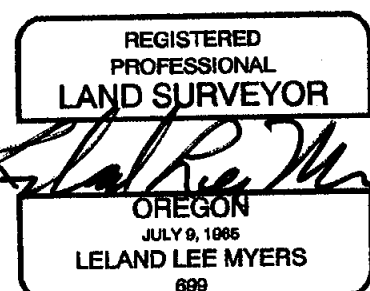

Renewal Date 1/1/97

T10S R37E R-17