

CERTIFIED RECORD OF LAND CORNER MONUMENTATION

History of original corner establishment:

Not previously set.

DIAGRAM

T10S R37E

NE1/16 + S26

1994
PLS699

Description of corner evidence found:

Corner is being set by this survey.

Description of monument and accessories established to perpetuate the original location of this corner:

Set 2" aluminum pipe with 3 1/4" aluminum cap, stamped as shown in diagram, 22" in ground, to hard pan, at a point as determined by the procedures set forth in the MANUAL OF INSTRUCTIONS FOR THE SURVEY OF PUBLIC LANDS for the subdivision of sections, in mound of earth and rock 30" base, 8" high, from which new accessories are:

A 6" Western larch, bears N86°10'W, 41.53 ft., scribed "NE1/16 S26 BT"

An 8" Douglas Fir, bears S28°45'E, 6.57 ft., scribed "NE1/16 S26 BT"

Also set galvanized steel posts with "Property Boundary" and "Land Survey Monument" sign 5 ft. W. and "Property Boundary" sign 3 ft. S.

I, Leland Lee Myers, 587 E Auburn Street, PO Box 98, Sumpter, OR 97877, do hereby certify that on November 19, 1994, I monumented the corner as herein described.


FILED IN THE OFFICE OF THE BAKER COUNTY SURVEYOR THIS

7 DAY OF Feb, 1995.

10-37-66

Baker County Surveyor

Client: Lyle Defrees & US Forest Service

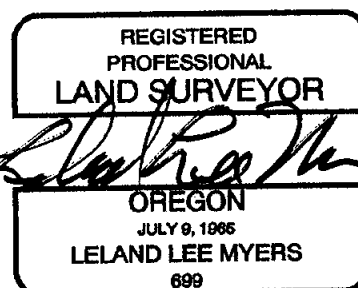

Renewal Date 1/1/97

T10S R37E S-20