RECORD OF SURVEY

A TRACT OF LAND SITUATED IN SOUTHEAST QUARTER OF SECTION 4, TOWNSHIP 10 SOUTH, RANGE 37 EAST OF THE WILLAMETTE MERIDIAN, COUNTY OF BAKER, STATE OF OREGON.



HORIZONTAL DATUM

NAD 83/2011 EPOCH 2010.0000 OREGON STATE PLANE COORDINATE SYSTEM NORTH ZONE 3601 WITH UNITS IN INTERNATIONAL FEET.

A GNSS VECTOR OBSERVED BETWEEN THE MONUMENTS SHOWN AT POINTS 'A' AND 'D', IS THE BASIS OF BEARINGS FOR THIS SURVEY, BEARING BEING S 88°04'32" W.

POINT NO.	NORTHING	EASTING	DESCRIPTION
'A'	393971.493	8804853.399	1/2" IR W/RPG
'B'	393949.141	8804188.155	1/2" IR W/YP0

SCALE: 1" = 100'



LEGEND

- = DENOTES FOUND MONUMENT AS NOTED
- O = DENOTES A 5/8" X 30" IRON ROD WITH YELLOW PLASTIC CAP MARKED, "SWLS INC", SET ON 2 MAY 2025

IR = IRON ROD

IP = IRON PIPE

SN = SURVEY NUMBER, BAKE COUNTY SURVEY RECORDS

W/YPC = WITH YELLOW PLASTIC CAP

() = RECORD INFORMATION AS REFERENCED

REFERENCE PLATS

P2 = THREE BAR RANCH LANDS

BAKER COUNTY PLAT RECORDS

P1 = HAVEN OF REST

P3 = PARTITION PLAT NO 10-37-0034

REFERENCE SURVEYS

BAKER COUNTY SURVEY RECORDS

S1 = SN 10-37-0033

REFERENCE DEEDS

BAKER COUNTY DEED RECORDS

D1 = DOCUMENT NO B22 30 0138

NARRATIVE

THE PURPOSE OF THIS SURVEY IS TO MONUMENT A TRACT OF LAND SITUATED IN SOUTHEAST QUARTER OF SECTION 4, TOWNSHIP 10 SOUTH, RANGE 37 EAST OF THE WILLAMETTE MERIDIAN, COUNTY OF BAKER, STATE OF OREGON, THAT CERTAIN TRACT OF LAND DESCRIBED IN DOCUMENT NUMBER B22 30 0138, BAKER COUNTY DEED RECORDS.

THE PROJECT BEGAN WITH A SEARCH FOR, AND SURVEY OF EXISTING MONUMENTS CONTROLLING THE SUBJECT PROPERTY AS SHOWN. UTILIZING SAID DEED AND EXISTING EVIDENCE FOUND ON THE GROUND, THE DEED LINES WERE DETERMINED AS FOLLOWS:

THE NORTHEAST LINE ALSO BEING THE SOUTHWEST LINE OF TRACT B WERE DEFINED BY HOLDING THE MONUMENTS AT POINTS 'E', 'G' 'I', 'K' AND 'O' PER BAKER COUNTY SURVEY NUMBER 10-37-0033.

THE SOUTHEAST LINE ALSO BEING THE SOUTHEAST LINE OF TRACT 'B' AND THE WESTERLY RIGHT OF WAY OF DREDGE SHOP ROAD WAS DEFINE BY THE MONUMENTS AT POINTS 'N', O', AND 'Q' THEN EXTENDED SOUTHWESTERLY A CORD DISTANCE OF 55.18' PER BAKER COUNTY SURVEY NUMBER 10-37-0033

THE SOUTH LINE, AND THE WEST LINE WERE ESTABLISHED USING A DISTANCE-DISTANCE INTERSECTION OF DEED DISTANCES OF 500.00' WESTERLY FROM THE SOUTHEAST CORNER OF SAID TRACT AND 200.00' SOUTHERLY FROM THE NORTHWEST CORNER OF SAID TRACT A THROUGH THE MONUMENT FOUND AT POINT

THE NORTHEAST LINE WAS DEFINED BY MONUMENT AT POINTS 'F', 'J' AND 'N' PER BAKER COUNTY SURVEY NUMBER 10-37-0033.

THE SOUTHWEST LINE WAS DEFINED BY THE MONUMENTS AT POINTS 'F' AND 'I', PER BAKER COUNTY SURVEY NUYMBER 10-37-0033. THEN MONUMENTS WERE SET AS SHOWN

> BAKER COUNTY SURVEYOR SURVEY NO. 10-37-137

55.20

132.40'

413.57

(C14

602.96

602.96

602.96


602.96

602.96

4*51'27"

12°25'03"

39'17'57"

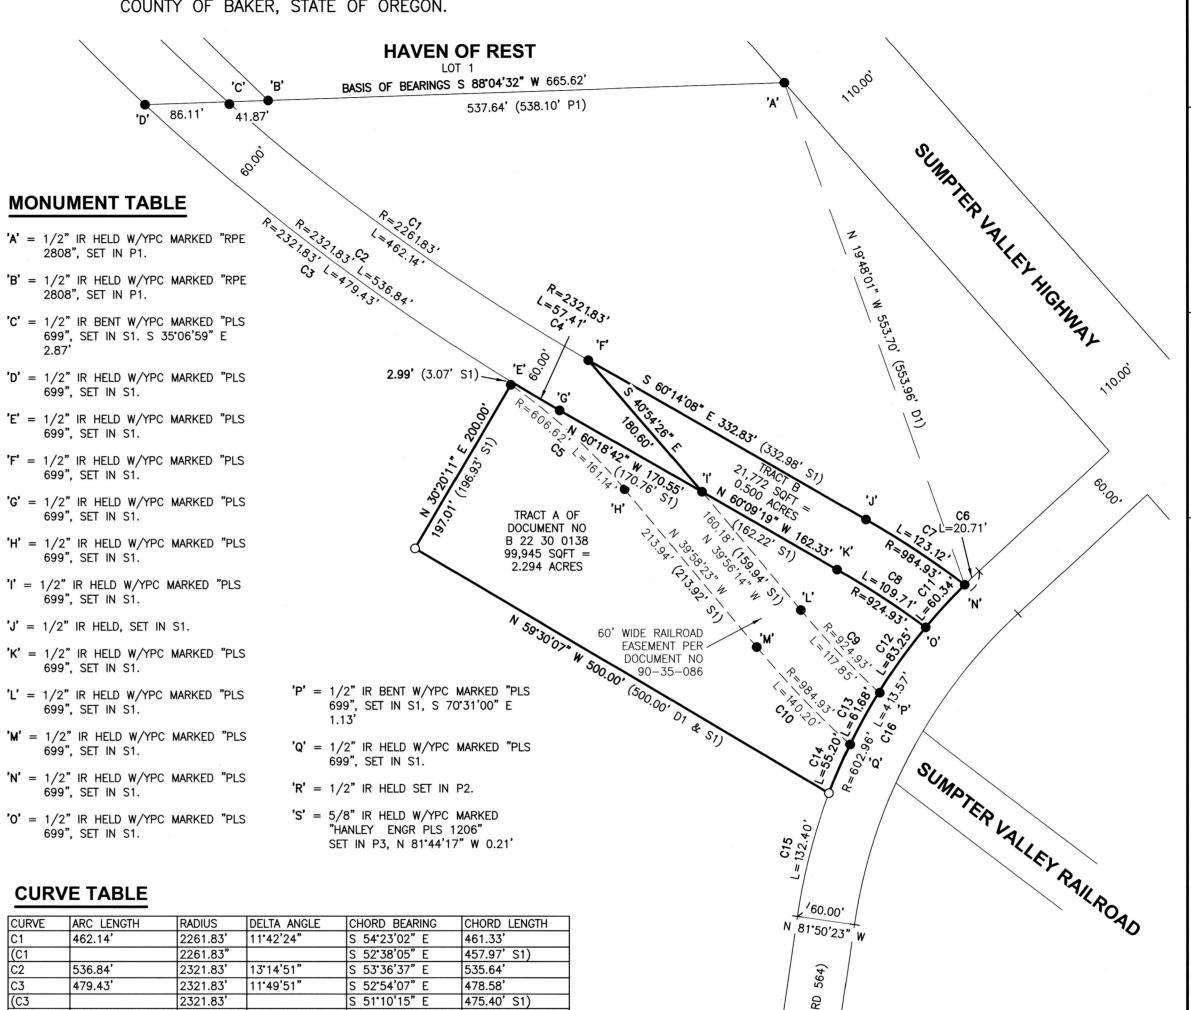

2321.83 1'25'00' N 59°31'32" W 57.41 N 57°55'25" W 2321.83' 5736' S1) 161.14' 606.62 N 47*33'23" W 160.66 160.63 S1) 606.62 S 45'58'00" E 20.71 20.71 602.96' 1*58'05' N 46°28'31" E 602.96 6 48°09'30" W 20.71' S1) 123.12' S 56'39'40" E 123.04 984.93' 7'09'44" 984.93' S 55'02'50" E 123.15' S1) 6°47'46" 109.71 924.93 S 56'51'10" E 109.65 S 55'14'05" E 109.59' S1) 924.93' N 43°31'57" W C9 (C9 117.85 7'18'02" 924.93' 117.77 924.93 S 42'00'15" E 117.65' S1) C10 40.20 N 43'59'08" W 984.93' 8'09'21' 140.08 984.93' 6 42°25'50" E 139.88' S1) 60.34 602.96 5'44'01' S 42°37'28" W 60.31 S 44°18'25" W 60.33' S1) 602.96 83.18' 83.25 602.96 7*54'38' N 35°48'09" E 602.96 S 37'29'25 W 83.06' S1) C13 61.68 602.96' 5.51,39" N 28'55'00" E 61.65 602.96 S 30°37'10" E 61.65' S1)

S 23'27'39" W

S 25°02'50" W

S 14°24'38" W

S 16°08'15" W

N 27°48'35" E

55.18

55.18' S1)

LOT 29

TREE BAR RANCH LANDS

132.15 132.25' S1)

405.51

DRED(60.00' PARCEL 1 PARTITION PLAT NO 10-37-0034

REGISTERED

PROFESSIONAL

LAND SURVEYOR

OREGON SEPTEMBER 13, ERIC HYATT 99516

EXPIRES: 06/30/25

 $^{\circ}$

09)

SHOP ROAD

43 NW AVA AVE 1915 WASHINGTON AVE GRESHAM, OR 97030 BAKER CITY, OR 97814 503-665-7777 541-406-3012 SURVEY@STATEWIDESURVEYING.COM

REV:

5/9/2025

DATE:

REVIEW

REVIEWED:

WEIT

DAN

10B

5/2/2025