

**LEGEND**


- CENTERLINE, BAKER-SUMPTER HIGHWAY
- CENTERLINE, POWDER RIVER
- SET 5/8" IRON ROD AT HWY. R/W BOUNDARY
- SET 5/8" IRON ROD

**REFERENCES -**

(1) OREGON STATE HIGHWAY DRWG # 5B-35-6

BASIS OF BEARING: SOLAR OBSERVATION

SCALE: 1 INCH = 300 FEET

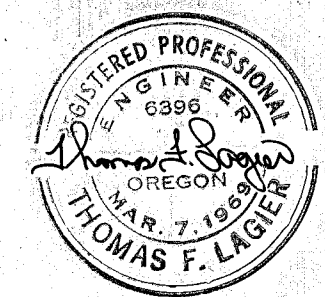

RECORD OF SURVEY FOR  
**JOHN KIRBY**

IN PORTIONS OF SECTIONS 28, 33, +34, T 10S., R 39E. W.M.  
BAKER COUNTY OREGON

FILED Aug. 13, 1971  
BAKER COUNTY SURVEYOR  
SURVEY NO. 10-39-5

SURVEYED BY - TELEK ENGINEERING, BAKER  
AUGUST 1971