


**NOTE:**

The U.S. Forest Service alpha-numeric method of corner referencing is shown on the north and west edges of this drawing. Baker County Surveyor has adopted this method for county filing of the original certified monumentation records.

Map data reflects section subdivision computations based on this Marble cadastral survey. The following is a tabulation of differences in found BLM monumentations with computed positions based on this survey.

- 33/4 1/4 (A-12) mon. is 0.02 north, 1.09 west
- 34/3 1/4 (A-14) mon. is 0.29 north, 0.63 west

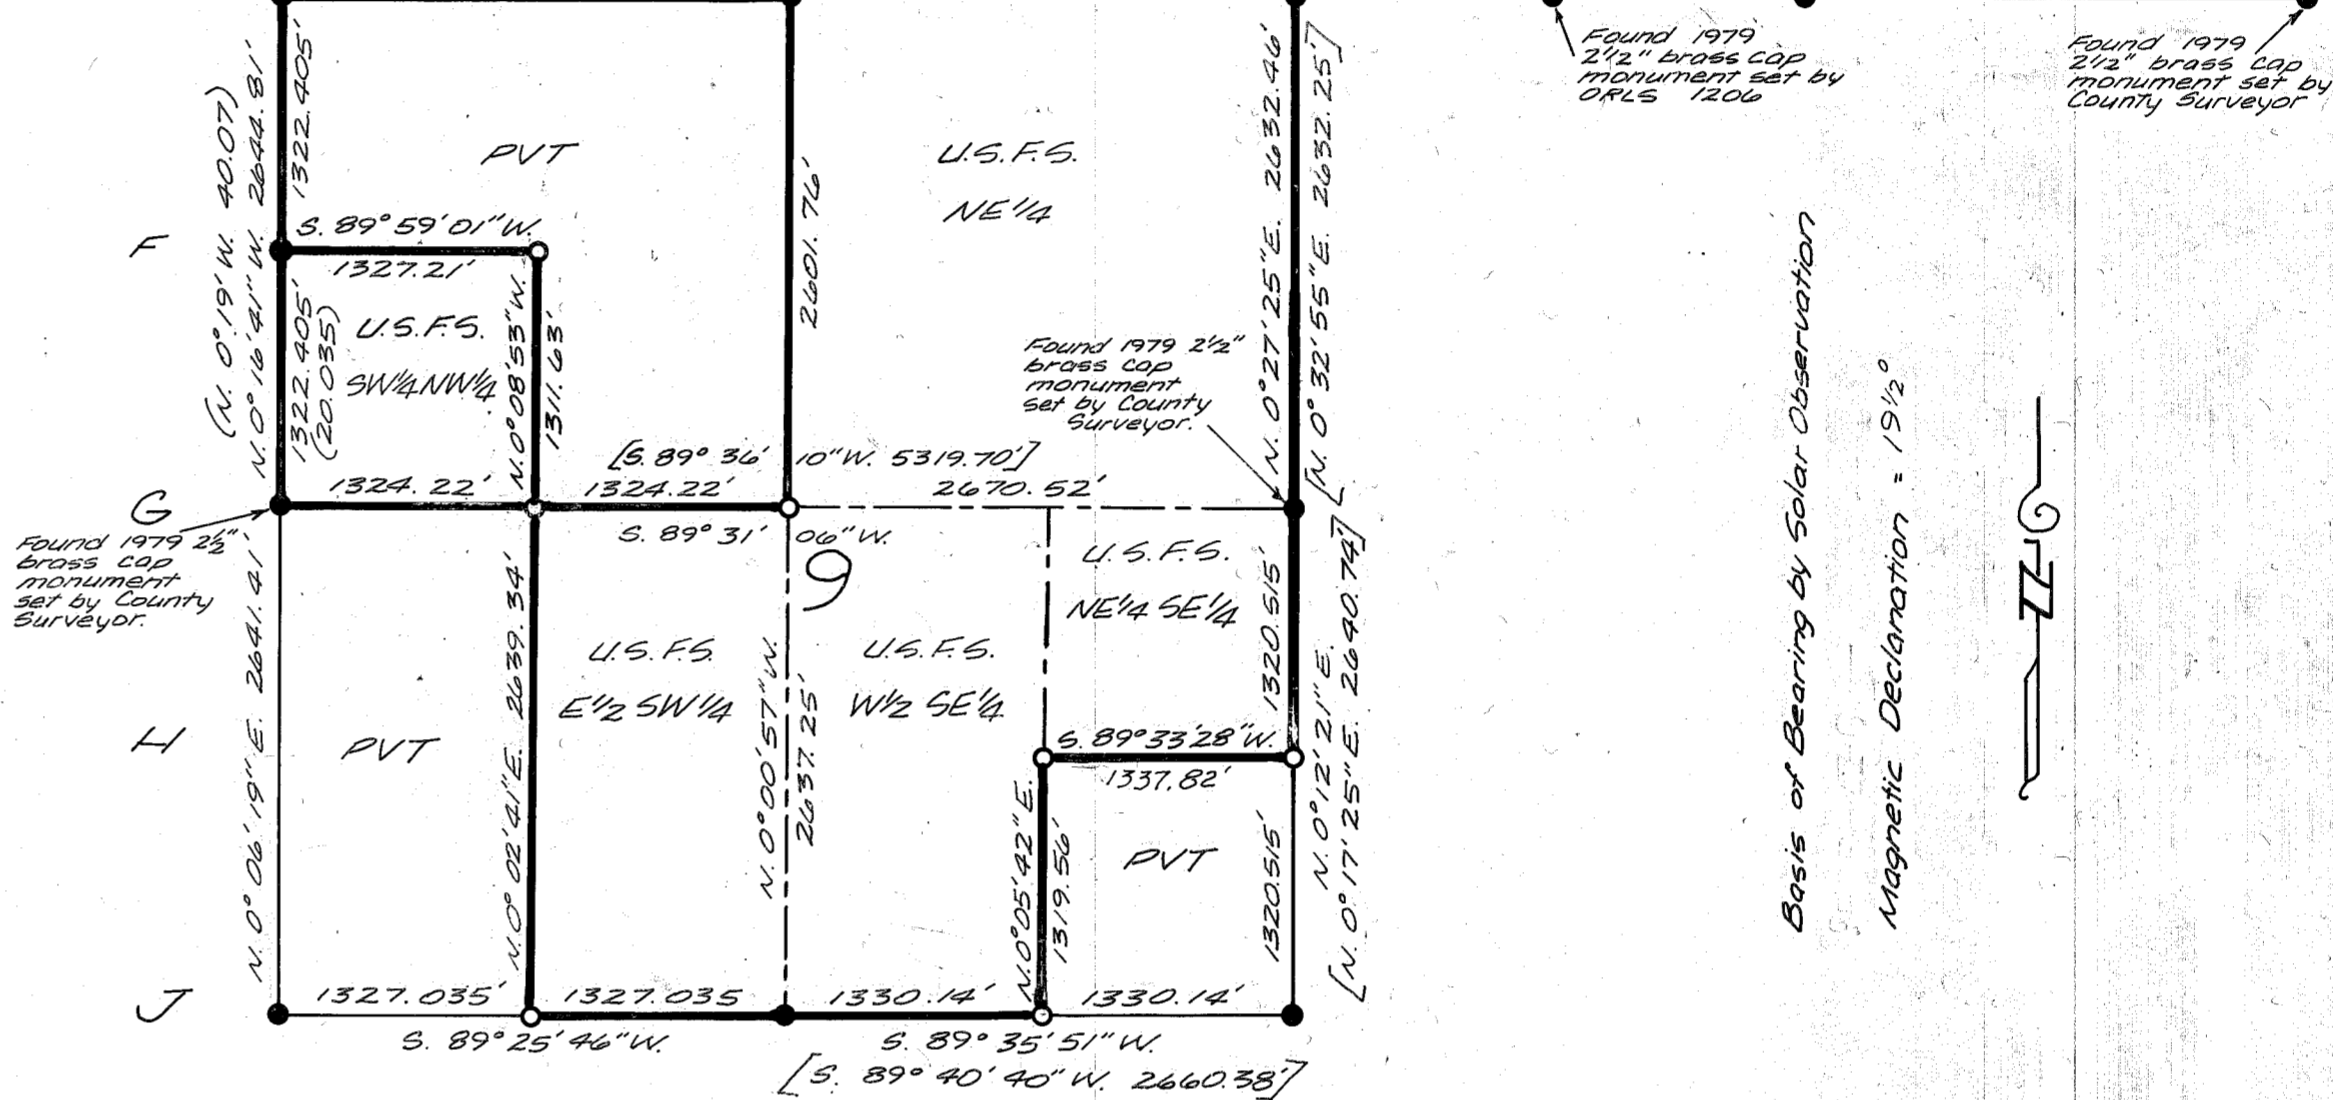

Basis of Bearing by Solar Observation  
Magnetic Declination = 19 1/2'

**LEGEND**

- ( ) BLM Record 1983
- [ ] Auburn Subdivision Plot
- Found, 3/4-inch diam. BLM brass cap on 2 1/2 inch iron pipe, unless otherwise noted
- Set 2 1/2-inch diam. brass cap on 2 1/2-inch iron pipe
- Posted boundary lines between U.S. and private lands. (Posted to U.S.F.S. standard)

**HISTORY OF LAND SURVEYS IN T.10S., R.39 E., W.1M.**

The history of surveys of the area represented on this Record of Survey are as follows:

In 1843, Timothy W. Davenport surveyed the north and west boundaries.


In 1864, David P. Thompson and Daniel Chaplin surveyed a portion of the subdivisional lines.

In 1879, Henry M. Thatcher completed the subdivisional lines. The Thatcher plat of survey was added to the 1884 Thompson and Chaplin plat.

In 1970, Albert J. Garrison and Owen C. Chatters II, remonumented certain original corner points along the north boundary of the township without survey.

In 1971 and 1972, Gerald E. Chittick and John H. Nelson resurveyed a portion of the north boundary.

In 1983, William D. Kimmel resurveyed a portion of the north boundary and subdivisional lines in sections 5 and 6.

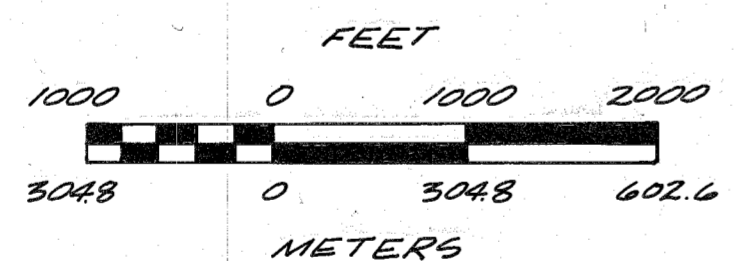

**RECORD OF SURVEY**  
FOR U.S. FOREST SERVICE  
**MARBLE CADASTRAL**  
BY HANLEY ENGINEERING  
BAKER, OREGON  
CONTRACT No. 53-04HI-9638N

FILED 6-23-86  
BAKER COUNTY SURVEYOR  
SURVEY NO. 10-39-80  
Sec 9-39-200

REGISTERED PROFESSIONAL LAND SURVEYOR  
James D. Hanley  
OREGON  
SEPTEMBER 23, 1977  
JAMES D. HANLEY  
1206