


CERTIFIED RECORD OF LAND CORNER MONUMENTATION

HISTORY OF ORIGINAL CORNER ESTABLISHMENT:


THE ORIGINAL SURVEY OF GUIDE MERIDIAN BETWEEN RANGES 39 AND 40 WAS DONE BY TIMOTHY W. DAVENPORT UNDER GENERAL LAND OFFICE CONTRACT NO. 102, DATED JULY 20, 1863. THE FIELD NOTES FOR THIS SURVEY STATE: "SET POST CORNER TO SECS. 19, 30, 24 & 25 ON TOP OF RIDGE, MADE MOUND OF ROCK.

CORNER PERPETUATED BY JIM HANLEY, CS 10-40-4, IN 1978. HE FOUND A "9"X6" BASALT STONE, 7" ABOVE GROUND MARKED WITH 4 GROOVES ON N., 2 ON S., AND 5 ON EAST FACES IN ANCIENT FENCE LINE. HE REMONUMENTED THE CORNER "WITH 2 1/2" BRASS CAP ON 1" I.P., BURIED STONE ALONGSIDE.

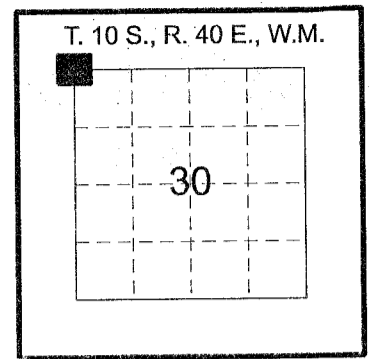

DESCRIPTION OF CORNER EVIDENCE FOUND:

FOUND 2.5" DIAMETER BRASS CAP ON 1" DIAMETER IRON PIPE MARKED AS SHOWN PER BAKER COUNTY SURVEY NO. 10-40-4.

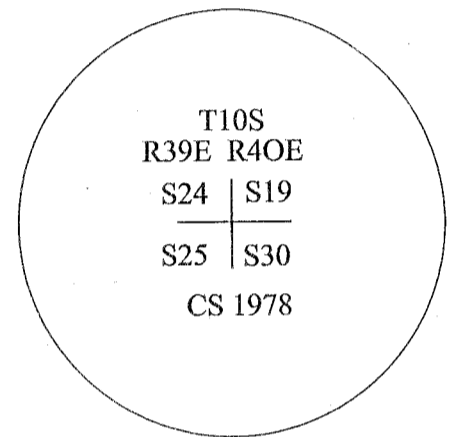

DESCRIPTION OF MONUMENT AND ACCESSORIES ESTABLISHED TO PERPETUATE THE ORIGINAL LOCATION OF THIS CORNER:

NO ADDITIONAL ASSESSORIES ESTABLISHED.

WHITNESSES:
MARK FILSINGER, MARK STEWART, CODY WHEELER

I HEREBY CERTIFY THAT THE ABOVE CORNER POSITION WAS PERPETUATED AS HEREON DESCRIBED IN MAY, 2012.

FILED Sept. 27, 2012
BAKER COUNTY SURVEYOR
SURVEY NO. 10-39-178 (R-1)
10-40-29 (R-25)

REGISTERED
PROFESSIONAL
LAND SURVEYOR

Mark D. Filsinger

OREGON
JULY 20, 1993
MARK D. FILSINGER
2613

RENEWS: 12/31/2013

OREGON DEPARTMENT OF TRANSPORTATION



Section	BUNDLE 457: RANCHERIA & SALISBURY BR.		
Highway	WHITNEY NO. 71 (OR 7)		
County	BAKER	Scale	NTS
Purpose	RW RE-ALIGNMENT	Date	February, 2012