


CERTIFIED RECORD OF LAND CORNER MONUMENTATION

HISTORY OF ORIGINAL CORNER ESTABLISHMENT:

THE ORIGINAL SURVEY OF GUIDE MERIDIAN BETWEEN RANGES 39 AND 40 WAS DONE BY TIMOTHY W. DAVENPORT UNDER GENERAL LAND OFFICE CONTRACT NO. 102, DATED JULY 20, 1863.

SECTIONS 29, 30 AND 31 WERE SUBDIVIDED BY CHARLES M. FOSTER UNDER GENERAL LAND OFFICE SPECIAL CONTRACT DATED FEBRUARY 16, 1889.

IN 1915 BAKER COUNTY SURVEYOR IRA HOFFMAN SET A 4" x 4" x 20" STONE MARKED "1/16" ON EAST FACE.

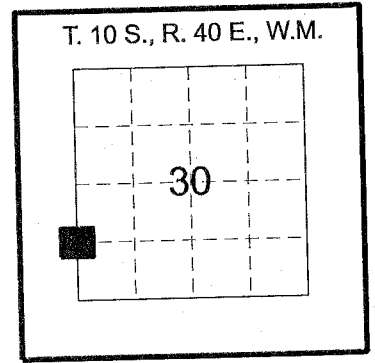

DESCRIPTION OF CORNER EVIDENCE FOUND:

FOUND 4" x 4" x 20" STONE MARKED "1/16" ON EAST FACE, SET BY BAKER COUNTY SURVEYOR IRA HOFFMAN IN 1915, PLANTED FIRMLY IN THE GROUND IN NORTH-SOUTH FENCE LINE 1.8 FEET SOUTH OF FENCE CORNER.

DESCRIPTION OF MONUMENT AND ACCESSORIES ESTABLISHED TO PERPETUATE THE ORIGINAL LOCATION OF THIS CORNER:

NO NEW CORNER MONUMENT SET.
FROM ORIGINAL MONUMENT:

- 1) SET 1/2" X 30" SQUARE IRON ROD WITH A 1.5" ALUMINUM CAP STAMPED "ODOT" BEARS S55°W 7.2 FT.
- 2) SET 1/2" X 30" SQUARE IRON ROD WITH A 1.5" ALUMINUM CAP STAMPED "ODOT" BEARS S56°E 11.0 FT.

THE BEARINGS SHOWN ARE BASED ON A SILVA HAND COMPASS, DECLINATION=17.5° EAST OF NORTH

WITNESSES:
MARK FILSINGER, MARK STEWART, CODY WHEELER


I HEREBY CERTIFY THAT THE ABOVE CORNER POSITION WAS PERPETUATED AS HEREON DESCRIBED IN MAY 2012.

FILED Sept 27, 2012

BAKER COUNTY SURVEYOR (u-1)
10-39-180
SURVEY NO. 10-40-34 (u-25)

RENEWS: 12/31/2013

REGISTERED PROFESSIONAL LAND SURVEYOR
Mark D. Filsinger
OREGON
JULY 20, 1993
MARK D. FILSINGER
2613

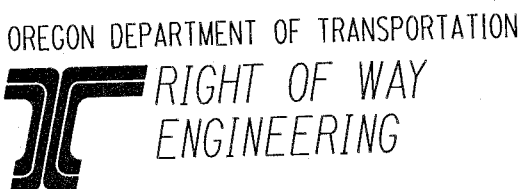

Section	BUNDLE 457: RANCHERIA & SALISBURY BR.		
Highway	WHITNEY NO. 71 (OR 7)		
County	BAKER	Scale	NTS
Purpose	RW RE-ALIGNMENT	Date	February, 2012