


CERTIFIED RECORD OF LAND CORNER MONUMENTATION

HISTORY OF ORIGINAL CORNER ESTABLISHMENT:

THE ORIGINAL SURVEY OF GUIDE MERIDIAN BETWEEN RANGES 39 AND 40 WAS DONE BY TIMOTHY W. DAVENPORT UNDER GENERAL LAND OFFICE CONTRACT NO. 102, DATED JULY 20, 1863. THE FIELD NOTES FOR THIS SURVEY STATE:

"SET POST CORNER TO SECS. 30, 31, 25, & 36, MADE MOUND OF EARTH AND DROVE CHARRED STAKE..."

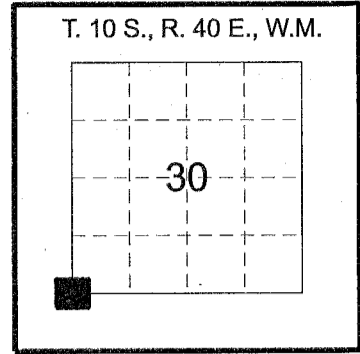

DESCRIPTION OF CORNER EVIDENCE FOUND:

FOUND 1" IRON ROD 9" BELOW THE GROUND IN PASTURE PER UNRECORDED MAP OF SURVEY BY LELAND MYERS, PLS 699, FITS WELL TO GLO CALLS, FROM WHICH A

- 1) FOUND PK NAIL WITH WASHER STAMPED "PLS 699" PER UNRECORDED LELAND MYERS SURVEY BEARS N56° 54'E 206.17 FT. (N58° 39'16"E 206.09').
- 2) FOUND PK NAIL WITH WASHER STAMPED "PLS 699" PER UNRECORDED LELAND MYERS SURVEY BEARS S19° 59'E 178.48 FT. (S18° 12'47"E 178.50').
- 3) FOUND PK NAIL WITH WASHER STAMPED "PLS 699" PER UNRECORDED LELAND MYERS SURVEY BEARS S78° 47'W 361.47 FT. (S80° 32'16"W 361.55').
- 4) FOUND PK NAIL WITH WASHER STAMPED "PLS 699" PER UNRECORDED LELAND MYERS SURVEY BEARS N47° 48'W 319.74 FT. (N46° 03'30"W 319.78').
- 5) FOUND 3/4" IRON ROD (UNRECORDED) JUST BELOW PASTURE SURFACE BEARS N03° 04'E 12.02 FT.

DESCRIPTION OF MONUMENT AND ACCESSORIES I ESTABLISHED TO PERPETUATE THE ORIGINAL LOCATION OF THIS CORNER:

NO ADDITIONAL REFERENCES WERE ESTABLISHED.

WHITNESSES:
MARK FILSINGER, MARK STEWART, CODY WHEELER

I HEREBY CERTIFY THAT THE ABOVE CORNER POSITION WAS PERPETUATED AS HEREON DESCRIBED IN MAY, 2012.

REGISTERED
PROFESSIONAL
LAND SURVEYOR



OREGON
JULY 20, 1993
MARK D. FILSINGER
2613

FILED Sept. 27, 2012

BAKER COUNTY SURVEYOR (V-1)
10-39-181
SURVEY NO. ~~10-40-38~~ (V-25)

RENEWS: 12/31/2013

OREGON DEPARTMENT OF TRANSPORTATION



Section	BUNDLE 457: RANCHERIA & SALISBURY BR.		
Highway	WHITNEY NO. 71 (OR 7)		
County	BAKER	Scale	NTS
Purpose	RW RE-ALIGNMENT	Date	February, 2012