

# RECORD OF LAND CORNER MONUMENTATION


SOUTH-NORTH 1/64 CORNER SECTION 4, T. 10 S., R. 39 E., W.M.

ORIGINALLY ESTABLISHED BY: Thomas J. Hanley, PLS

RECORD SURVEY NUMBER: Baker County Survey No. 10-39-168

RECORDING DATE: August 11, 2004

SUBSEQUENT SURVEYS: N/A

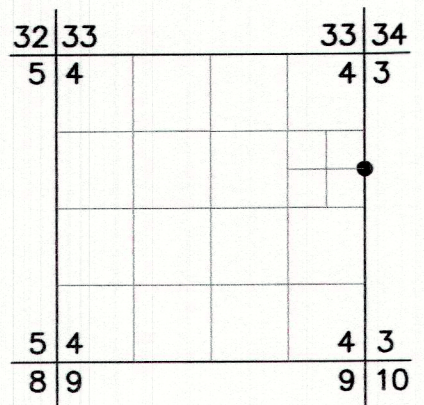

**ORIGINAL DESCRIPTION:** Survey No. 10-39-168 shows a 5/8" rebar with plastic cap marked "HANLEY ENGR. PLS 1817" set at the corner.

**EVIDENCE FOUND:** Found a 5/8" rebar with yellow plastic cap marked as previously described, projecting 6 inches above ground in a mound of stone. Also found two steel T posts inside white pvc pipes set north and alongside. I accept the position of the found rebar monument for the 1/64 corner.


**DESCRIPTION OF MONUMENTS AND ACCESSORIES SET AND METHODS USED:**

At the corner point, I drove the found 5/8" rebar down below ground and set a standard USFS 2½"x30" aluminum pipe with attached 3¼" aluminum cap over the top of the rebar, 18" in the ground. Raised a 3 ft. diameter mound of stone around the monument to base of cap. Cap is marked as shown below.

MONUMENT MARKED:

From which, I SCRIBE THE FOLLOWING BEARING TREES:

- ▶ A 17" dbh ponderosa pine bears N.76°45'E., 57.30 ft. marked "SN1/64 S3" in upper blaze and "BT" in lower blaze
- ▶ A 17" dbh ponderosa pine bears N.25°W., 14.14 ft. marked "SN1/64 S4" in upper blaze and "BT" in lower blaze

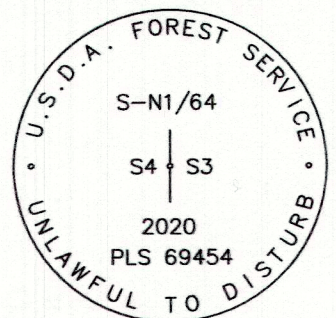

Painted a 6 inch red band around the bearing trees, and also painted the blazes red. Attached USFS 54-3 and 54-9 signs to the bearing trees.

Distances to bearing trees measured with a steel tape, measuring to a 40d nail driven in the side-center at the root crown of each tree. Used RTK GPS to measure the bearings to the trees. Bearings are based on Survey No. 10-39-168. Set an aluminum guard post with USFS 54-2 and 54-9 signs attached, 8.0 feet east of corner. The found T posts with pvc pipes were left in place.

**RESTORATION BY, STAMP AND DATE:**

Work Performed October 29, 2020 by:

Jason L. Hatfield, PLS  
Toribio J. Quinones

USDA FOREST SERVICE  
NORTHEAST OREGON LANDS ZONE  
1550 Dewey Avenue, Suite A  
Baker City, OR 97814  
(541) 523-1337

FILED November 25, 2020  
BAKER COUNTY SURVEYOR  
SURVEY NO. 10-39-185

