


CERTIFIED RECORD OF LAND CORNER MONUMENTATION

HISTORY OF ORIGINAL CORNER ESTABLISHMENT:

THE SUBDIVISION OF T10S, R40E, W.M. WAS ORIGINALLY SURVEYED BY THOMPSON AND CHAPLIN UNDER GENERAL LAND OFFICE CONTRACT NO. 104, APPROVED APRIL 16, 1864.

SECTIONS 29, 30 AND 31 WERE SUBDIVIDED BY CHARLES M. FOSTER UNDER GENERAL LAND OFFICE SPECIAL CONTRACT DATED FEBRUARY 16, 1889.

IN 1915 BAKER COUNTY SURVEYOR IRA HOFFMAN SET A 16" x 10" x 24" STONE MARKED "C1/16" ON EAST FACE.

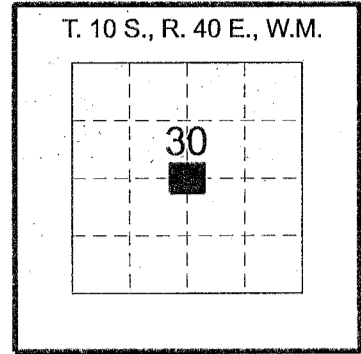

DESCRIPTION OF CORNER EVIDENCE FOUND:

FOUND 6" x 10 x 24" STONE MARKED "C1/16" ON EAST FACE, SET BY BAKER COUNTY SURVEYOR IRA HOFFMAN IN 1915, PLANTED FIRMLY IN THE GROUND 4 FEET SOUTH OF OLD ROAD AND S57° W 51.5' FROM SOUTHWEST FENCE CORNER.

DESCRIPTION OF MONUMENT AND ACCESSORIES I ESTABLISHED TO PERPETUATE THE ORIGINAL LOCATION OF THIS CORNER:

NO NEW CORNER MONUMENT SET.
FROM THE ORIGINAL STONE:

- 1) A 1/2" X 30" SQUARE IRON ROD WITH A 1.5" ALUMINUM CAP STAMPED "ODOT" BEARS S52° W 7.6 FT.
- 2) A 1/2" X 30" SQUARE IRON ROD WITH A 1.5" ALUMINUM CAP STAMPED "ODOT" BEARS S38° E 9.5 FT.

THE BEARINGS SHOWN ARE BASED ON A SILVA HAND COMPASS, DECLINATION=17.5° EAST OF NORTH

WHITNESSES:
MARK FILSINGER, MARK STEWART, CODY WHEELER

I HEREBY CERTIFY THAT THE ABOVE CORNER POSITION WAS PERPETUATED AS HEREON DESCRIBED IN MAY 2012. FILED Sept. 27, 2012

BAKER COUNTY SURVEYOR
SURVEY NO. 10-40-30


REGISTERED
PROFESSIONAL
LAND SURVEYOR

OREGON
JULY 20, 1993
MARK D. FILSINGER
2613

RENEWS: 12/31/2013

T-3

OREGON DEPARTMENT OF TRANSPORTATION

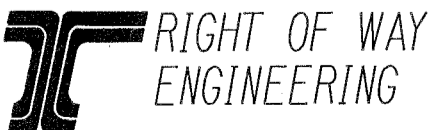

Section	BUNDLE 457: RANCHERIA & SALISBURY BR.		
Highway	WHITNEY NO. 71 (OR 7)		
County	BAKER	Scale	NTS
Purpose	RW RE-ALIGNMENT	Date	February, 2012