

CERTIFIED RECORD OF LAND CORNER MONUMENTATION


HISTORY OF ORIGINAL CORNER ESTABLISHMENT:

THE ORIGINAL SURVEY OF GUIDE MERIDIAN BETWEEN RANGES 39 AND 40 WAS DONE BY TIMOTHY W. DAVENPORT UNDER GENERAL LAND OFFICE CONTRACT NO. 102, DATED JULY 20, 1863.

THE SUBDIVISION OF T10S, R40E, W.M. WAS ORIGINALLY SURVEYED BY THOMPSON AND CHAPLIN UNDER GENERAL LAND OFFICE CONTRACT, APPROVED AUGUST 24, 1864.

SECTIONS 29, 30 AND 31 WERE SUBDIVIDED BY CHARLES M. FOSTER UNDER GENERAL LAND OFFICE SPECIAL CONTRACT DATED FEBRUARY 16, 1889.

IN 1915 BAKER COUNTY SURVEYOR IRA HOFFMAN SET A 6" x 14" x 21" STONE MARKED "1/4" ON EAST FACE.

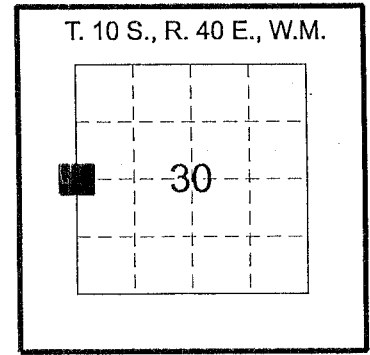

DESCRIPTION OF CORNER EVIDENCE FOUND:

FOUND 6" x 14" x 21" STONE MARKED "1/4" ON EAST FACE, SET BY BAKER COUNTY SURVEYOR IRA HOFFMAN IN 1915, PLANTED FIRMLY IN THE GROUND 1.0 FEET NORTH OF NORTHEAST FENCE CORNER IN MOUND OF STONE.

DESCRIPTION OF MONUMENT AND ACCESSORIES ESTABLISHED TO PERPETUATE THE ORIGINAL LOCATION OF THIS CORNER:

NO NEW CORNER MONUMENT SET FROM ORIGINAL MONUMENT:

- 1) A 5/8" X 30" IRON ROD WITH A 1.5" ALUMINUM CAP STAMPED "ODOT" BEARS N84°W 7.7 FT.
- 2) A 1/2" X 30" SQUARE IRON ROD WITH A 1.5" ALUMINUM CAP STAMPED "ODOT" BEARS S45°E 10.1 FT.
- 3) A 1/2" X 30" SQUARE IRON ROD WITH A 1.5" ALUMINUM CAP STAMPED "ODOT" BEARS N33°E 9.3 FT
- 4) A 1/2" X 30" SQUARE IRON ROD WITH A 1.5" ALUMINUM CAP STAMPED "ODOT" BEARS N71°W 15.8 FT.

THE BEARINGS SHOWN ARE BASED ON A SILVA HAND COMPASS, DECLINATION=17.5° EAST OF NORTH


WHITNESSES:
MARK FILSINGER, MARK STEWART, CODY WHEELER

I HEREBY CERTIFY THAT THE ABOVE CORNER POSITION WAS PERPETUATED AS HEREON DESCRIBED IN MAY, 2012.

FILED Sept 27-2012

BAKER COUNTY SURVEYOR
10-39-179
SURVEY NO. 10-40-32


REGISTERED
PROFESSIONAL
LAND SURVEYOR

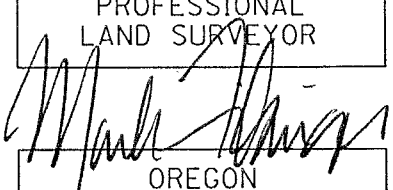

OREGON
JULY 20, 1993
MARK D. FILSINGER
2613

RENEWS: 12/31/2013

OREGON DEPARTMENT OF TRANSPORTATION

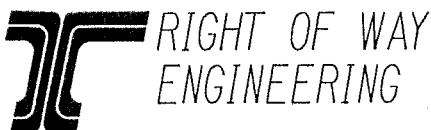

Section	BUNDLE 457: RANCHERIA & SALISBURY BR.		
Highway	WHITNEY NO. 71 (OR 7)		
County	BAKER	Scale	NTS
Purpose	RW RE-ALIGNMENT	Date	February, 2012