


CERTIFIED RECORD OF LAND CORNER MONUMENTATION

History of original corner establishment:

Corner established by Benjamin F. Vaughan under GLO contract no. 211 dated July 14, 1874, and approved by the Surveyor General on March 31, 1875.

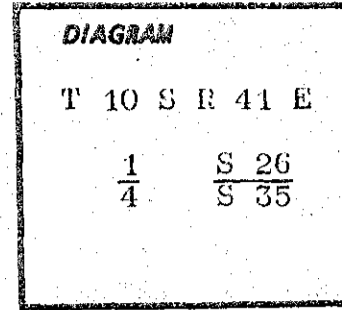

Record of original field notes state:

Set stone 18 x 10 x 6 for 1/4 Sec Cor

Description of corner evidence found:

Found a stone 16 x 11 x 6 marked 1/4 in an ancient downed fence line which runs north and 21 feet east of an existing fence intersection.

Description of monument and accessories I established to perpetuate the original location of this corner:


Set a 2½ inch brass cap on a 1 inch iron pipe 31 inches long and projecting 5 inches out of the ground with a surrounding rock mound. Buried original stone alongside and on the north side.

Brass cap marked thus: T 10 S R 41 E

$\frac{1}{4}$	$\frac{S 26}{S 35}$
---------------	---------------------

CS 1981

I hereby certify that the above corner monument was properly established under my supervision on Jan. 15, 1981, and witnessed by Brad Gordon, Tom Fisk and Jim DeNastus.

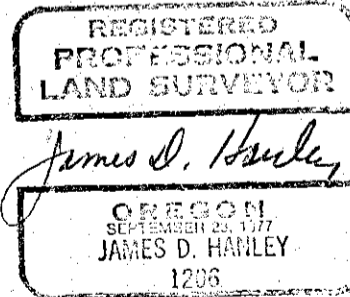

Office of..... County of.....
 State of....., I hereby certify that the within instrument was filed in this office
 for record on the..... day of....., 19.....
 by
 (COUNTY OFFICIAL) (DEPUTY)

Form R6-7100-57 (9/71)

☆ GPO—798-276

FILED Jan. 16, 1981
 DAKER COUNTY SURVEYOR
 SURVEY NO. 10-41-1