

**CERTIFIED RECORD OF LAND CORNER MONUMENTATION**

**HISTORY OF ORIGINAL CORNER ESTABLISHMENT:**

Originally established by N.O. Walden under Contract No. 198, dated July 14, 1873. Surveyor record states:

Set quartz stone 20x12x10, 10 in. in ground for corner to Secs 34, 35, 2, 3.

Corner found and reestablished by C. Albert White under special instructions dated September 3, 1940, included under Group No. 261. Surveyor record states:

The standard cor. of secs. 34 and 35, monumented with a stone, 14x10x10 ins., lying on the surface of the ground at a fence corner from which fences extend N., S., and W., mkd. With 6 grooves on one face, 2 grooves on another face and SC on another face.

From which:

A juniper, 6 ins. diam., bears N. 42°W., 176 lks. dist., mkd T10S R41E S34 BT.

**DESCRIPTION OF CORNER EVIDENCE FOUND:**

Found Bureau of Land Management 3" Brass cap on 2 1/2" iron post, protruding 4" above ground, from which:

A 16 inch juniper bears North 44° West, a distance of 115.8 feet, alive and vigorous with scribe marks visible on a partially healed blaze.

**DESCRIPTION OF MONUMENT AND ACCESSORIES I ESTABLISHED TO PERPETUATE THE ORIGINAL LOCATION OF THIS CORNER:**

**NEW BEARING OBJECTS:**


A 6 inch wooden fence post bears North 14° East, a distance of 14.95 feet, with brass washer marked OPLS 83571 nailed in top.

A 3 inch juniper bears South 2° East, a distance of 50.50 feet, marked X BT.


A 4 inch juniper bears South 63° West, a distance of 42.40 feet, marked X BT.

Corner falls West of fence corner 4.0 feet. Fencelines run North, South and East from corner.

I hereby certify that the corner was perpetuated on April 16, 2012  
Witness: Jeff Hsu

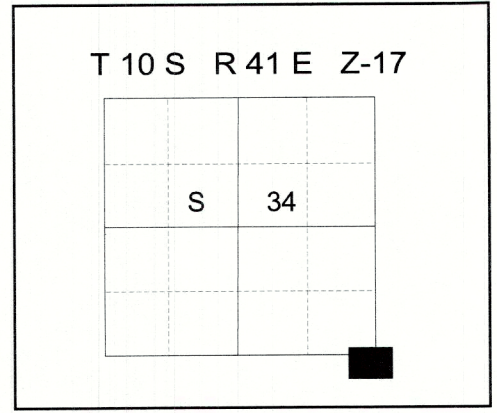

Renewal Date: June 30, 2013

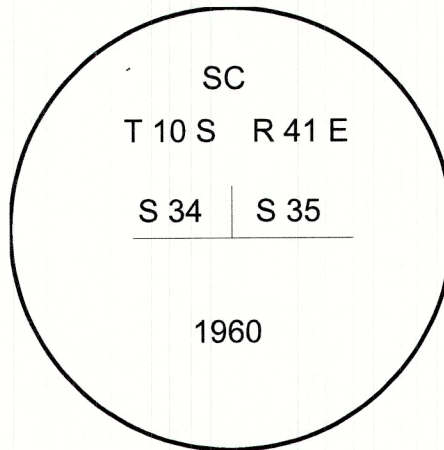

I used a steel tape and magnetic compass in the establishment of the bearing trees. I used 16° East declination. I attached a brass washer marked OPLS 83571 to the BT blaze. The distance is to a 60d spike driven into the root crown at the left side of the new bearing trees and to the center of the brass washer on the fence corner.

FILED May 12, 2011  
BAKER COUNTY SURVEYOR  
SURVEY NO. 10-11-20