


CERTIFIED RECORD OF LAND CORNER MONUMENTATION

**HISTORY OF ORIGINAL CORNER ESTABLISHMENT:**


Corner was never established.

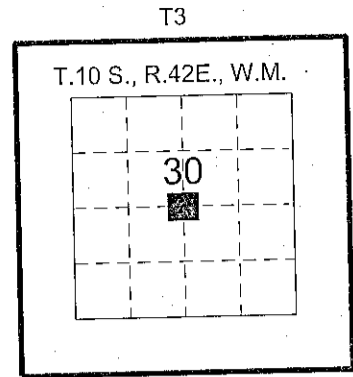

**DESCRIPTION OF CORNER EVIDENCE FOUND:**

**DESCRIPTION OF MONUMENT AND ACCESSORIES I ESTABLISHED TO PERPETUATE THE ORIGINAL LOCATION OF THIS CORNER:**

At position by intersection of Section 30 centerlines:  
 Set a 3 1/4 in. diam. alum. cap on a 2 1/2 in. diam. by 30 in. long aluminum post, buried 22 inches in the ground with clear DEEP-1 magnet at base and stone mound placed to top with 3 ft. base, a galv. iron sign post placed alongside NW'ly.  
 Marked as shown:

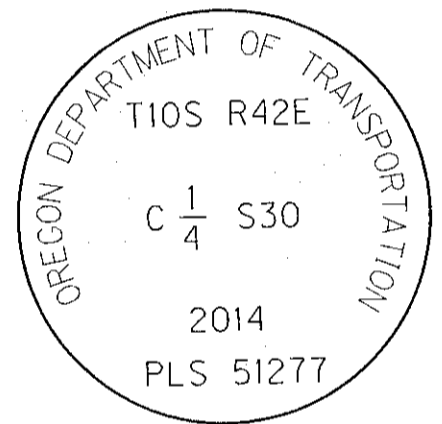

From which: I establish the following references:

A silver DEEP-1 magnet, buried 6 ins. in the ground on natural slope above corner, bears N 44° E, 7.00 FT.

A pink DEEP-1 magnet, buried 6 ins. in the ground on natural slope above corner, bears S 58° E, 5.50 FT.

A blue DEEP-1 magnet, buried 6 ins. in the ground on constructed cut slope below corner, bears S 44° W, 3.55 FT.

A orange DEEP-1 magnet, buried 6 ins. in the ground on natural slope below corner, bears N 52° W, 4.00 FT.

Accessories taken with hand compass set at 19° East declination and steel tape.

REGISTERED  
PROFESSIONAL  
LAND SURVEYOR

OREGON  
JULY 13, 1999  
PETER C. ELDER  
51277

FILED Aug. 5, 2014  
BAKER COUNTY SURVEYOR  
SURVEY NO. 10-42-10

Witness:  
Peter Elder

RENEWS: 12/31/2015

I hereby certify that the above corner position was perpetuated as hereon described on May 7, 2014.

	Section	Pleasant Valley - Durkee		
	Highway	Interstate 84, Old Oregon Trail		
	County	Baker	Scale	NTS
	Purpose	Quarry	Date	July 31, 2014
	File			