


CERTIFIED RECORD OF LAND CORNER MONUMENTATION

T. 10 S., R. 42 E.

R - 9

RECOVERED BY	COORDINATE SYSTEM, ZONE, & UNIT	
Matthew Faulkner, Oregon PLS	United States/NAD83, Oregon North 3601, International foot	
GCDB ID	NORTHING	EASTING
300300	380,552.23	8,960,083.10
LATITUDE	LONGITUDE	
N44°40'22.766"	W117°35'07.948"	

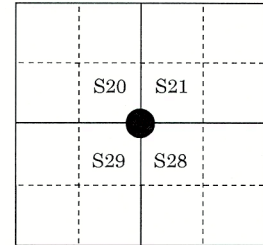

RECORD OF ORIGINAL CORNER AND SUBSEQUENT HISTORY:

The cor. of secs. 20, 21, 28 and 29, T. 10 S., R. 42 E., was originally established and described in the field notes of the survey of the subdivisional lines of T. 10 S., R. 42 E., Willamette Meridian, Oregon, executed by U.S. Deputy Surveyor Ben J. Vaughan in 1874 under Contract Number 211.

Description: Set stone, 16x10x8 ins. For cor. to secs. 20, 21, 28 and 29.

DESCRIPTION OF CORNER EVIDENCE FOUND AND DESCRIPTION OF MONUMENT AND ACCESSORIES ESTABLISHED TO PERPETUATE THE LOCATION OF THIS CORNER:

Recovery Date: 9/11/2023

Description: The cor. of secs. 20, 21, 28 and 29, monumented with a limestone, 15x10x6 ins. (**Record:** 16x10x8 ins.), lying loose in the center of an embedded mound of stone, 6x3 ft. in size, mkd. with 4 notches on an edge and 2 notches on an edge 90° to the 4-notch edge.

At the corner point

Set an aluminum post, 30 ins. long, 2 1/2 ins. diam., 26 ins. in the ground, over a plastic-encased magnet, and in a collar of stone, 1 1/2 ft. diam., to the top of an aluminum cap marked as shown on this corner record.

Buried the original limestone alongside the aluminum post. Added a witness mound of stone on E. edge of the collar of stone surrounding the aluminum post, 3 ft. base, 1 ft. high.

Set a carsonite post N. of the aluminum post, approximately 3 ft. dist.

FILED January 29, 2025

BAKER COUNTY SURVEYOR

SURVEY NO. 10-42-21

CERTIFIED RECORD OF LAND CORNER MONUMENTATION

Photo of the limestone monument, 15x10x6 ins., lying loose in the center of an embedded mound of stone, 6x3 ft. in size.



Photo No. 1 of the limestone monument with 4 notches on an edge.



Photo No. 2 of the limestone monument with 4 notches on an edge.



Photo of the limestone monument with 2 notches on an edge 90° to the 4-notch edge.



Photo of the aluminum cap markings.

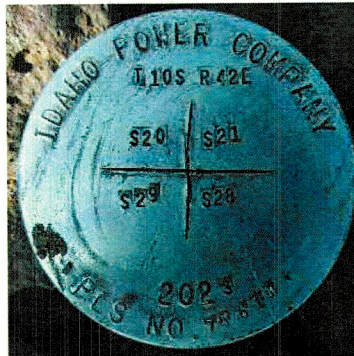


Photo of the aluminum monument set flush with the top of a collar of stone, with the rebuilt witness mound of stone on E. edge of the collar of stone.



BAKER COUNTY
SURVEYOR

Date Received

January 29, 2025

Date Filed

By

10-42-21

File No.

REGISTERED
PROFESSIONAL
LAND SURVEYOR

OREGON

JUNE 08, 2009

MATTHEW J. FAULKNER
75618LS

RENEWS: 12/31/25