BAKER COUNTY
OREGON
T.10S. R46E. W.M. ORE

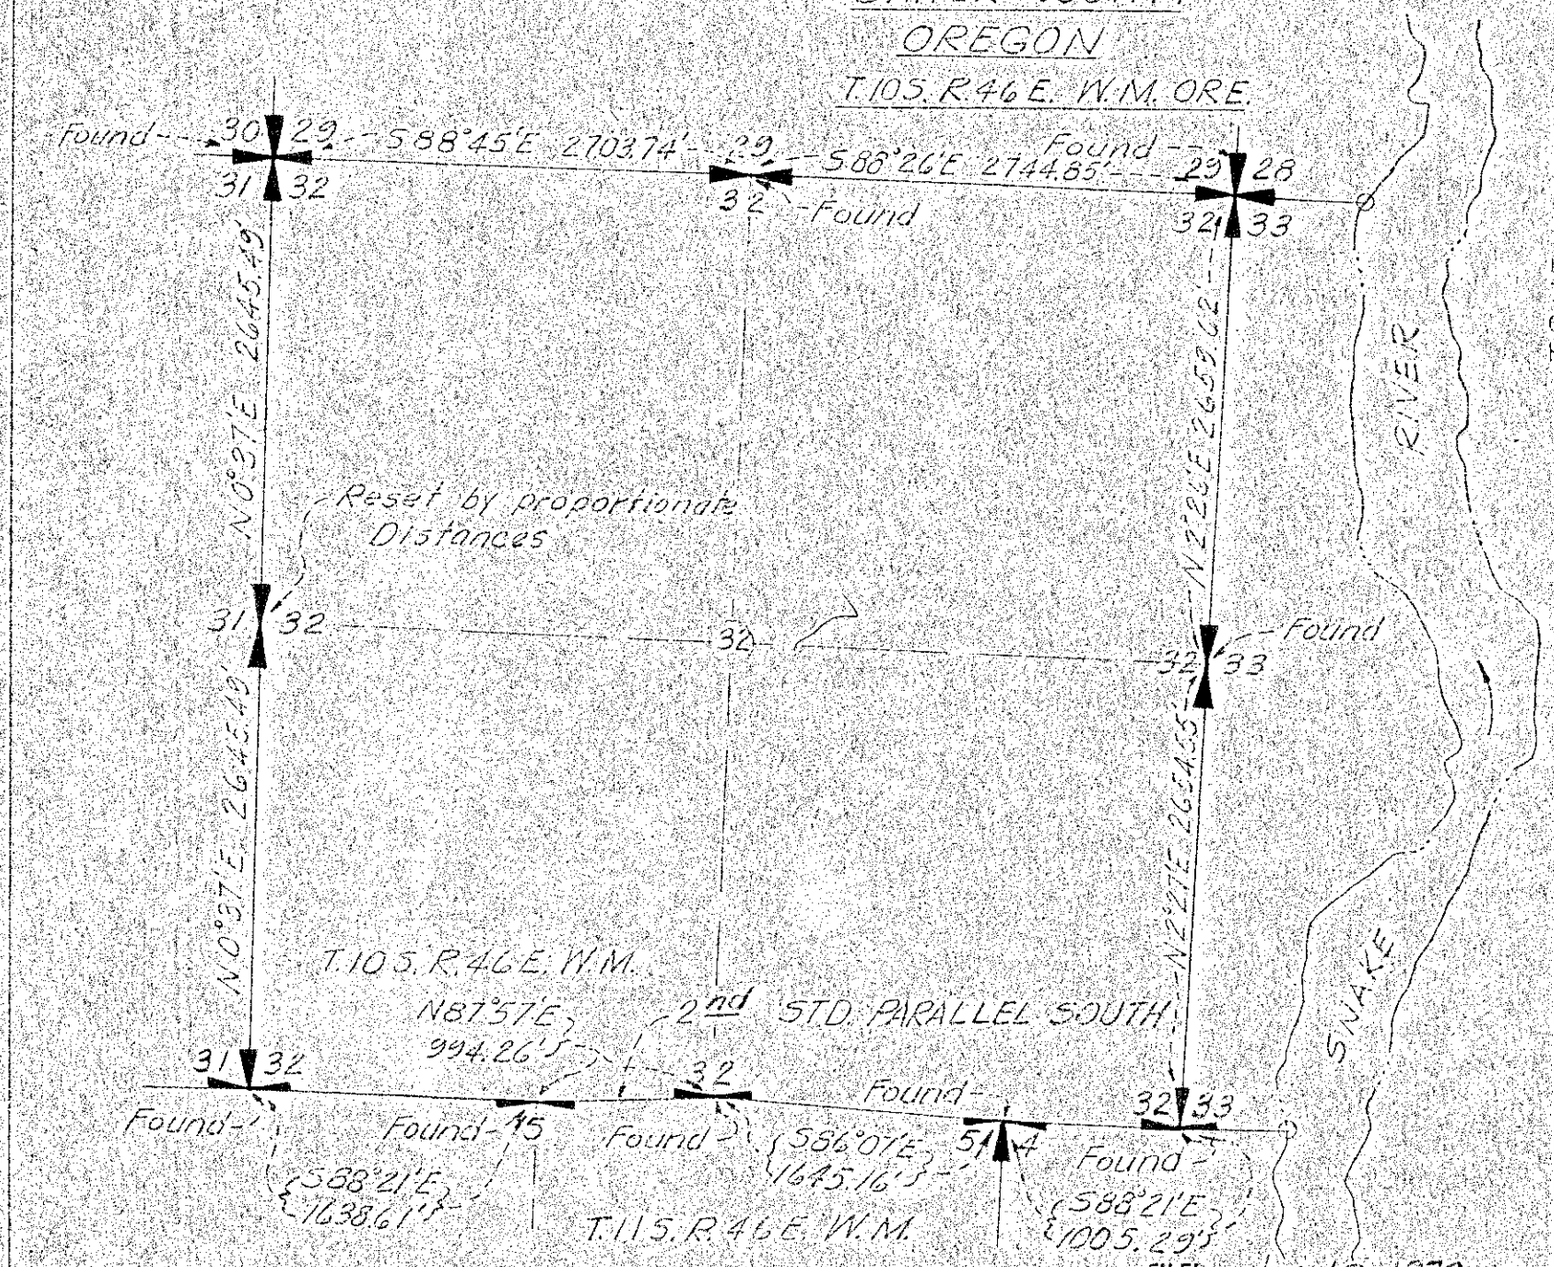

TRUE NORTH

REGISTERED OREGON LAND SURVEYOR
L. Bump
RENEWAL 1973
C. BUNA

WASHINGTON COUNTY
IDAHO
T.15N. R.6W. B.M. IDA.

LEGEND:

✚ FOUND OR RESET CORNERS

○ NOT FOUND MEANDER CORNERS

B-SK-27

BROWNLEE H.E. DEVELOPMENT

DEPENDENT RESURVEY of

SEC.32 & 33 T.10S. R.46E. W.M. ORE.

IDAHO POWER CO.

BOISE, IDAHO

SCALE: 1"=1000' July 18, 1957

DR. D.D.	APPROVED
TR.	
CH.	

20R-16709

FILED Jan 10, 1972

BAKER COUNTY SURVEYOR

SURVEY NO. 10-46-1

16-2