


CERTIFIED RECORD OF LAND CORNER MONUMENTATION

**History of original corner establishment:**

Original Survey by Eugene P. McCormack under contract No 398 dated July 2 1881  
 Intersected 2nd standard parallel south at a point 9.90 chs E of the standard cor to Tps 10S R35 & 36 E at which point I set a Basalt stone 16x14x9 ins 11 ins in the ground for closing corner to Tps 11S R35 & 36E marked cc with 6 notches on S,E, and W edges and raised a mound of stone along side. Pits impracticable;  
 retracement survey by K. P. Cecil under group No 99 dated October 1922 Set Basalt stone 18x16x5 ins 13 ins in the ground for closing corner to T11SRs 35½ & 36 E marked CC on S face with 6 notches S,E and W edges  
 I raised a mound of stone S of cor. from the cor.

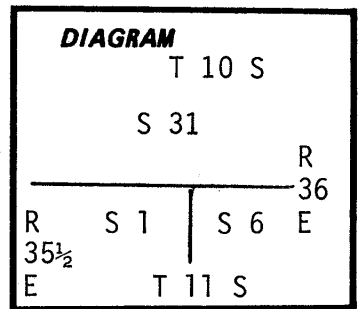

A Fir 16 ins diam., bears S41° 30'E 88 lks dist mkd. CC T11SR 36E S6BT (old markings but newly recorded)

A Pine 26 ins dia., bears S40° W 68 lks dist mkd. CC T11SR 35½E S1BT (old marking but newly recorded.)

A Pine, 22 ins dia., bears N25° W., 5 lks dist., markings on which a illegible in 1974 during a remonumentation project by the B.L.M of certain original corners they found the original stone in place as described and replaced it with a 2½"x28" iron post with a brass cap. They also found

A Fir 24 ins diam bears S41° E., 89 lks dist marked 11E S in partially healed blazes not of record

A Ponderosa Pine 30 ins diam bears S 39° W., 65 lks dist marks not legible in partially sealed blazes not of record.

**Description of corner evidence found:**

At the corner location I found the brass capped steel pipe as set by the BLM

I also found the three BTs as described by K. P. Cecil in 1922 and the two BTs as described by the B.L.M. in 1974.

A Fir 25" diam. bears. S 41° E 58.1 ft marked 11E,S

A Ponderosa Pine 30" diam, bears. S 40° W 44.9 ft blazes healed over.

The NW BT is partially burned and fell over no visible marks.

**Description of monument and accessories I established to perpetuate the original location of this corner:**


I replaced the NW Bearing Tree with

A 5" White Fir bears N 19° W 12.15 ft marked X BT nail in W. base.

Bearings taken with a staff compass declination 18½° E per 1980 Isogonic chart.

Distances pulled to 60d nails with brass washers stamped LS 1898 driven in the side center of the bearing trees.

Monument Stamped  
 T10S R36 E  
 S 31  
 S1 | S6  
 R35½E | R36E  
 T 11 S  
 CC  
 1974

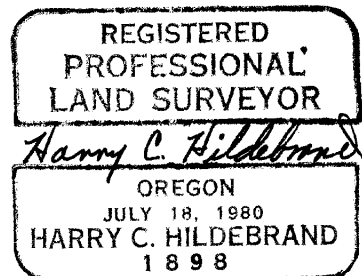

FILED Nov 23, 1982  
 BAKER COUNTY SURVEYOR  
 SURVEY NO. 11-35½-1

Office of... Surveyor..... County of... Baker.....  
 State of... Oregon..... I hereby certify that the within instrument was filed in this office  
 for record on the..... day of....., 19.....  
 ..... by .....  
 (COUNTY OFFICIAL) (DEPUTY)