


CERTIFIED RECORD OF LAND CORNER MONUMENTATION

History of original corner establishment:

Original Survey by Eugene P. McCormack under contract No 398 dated July 2 1881

Intersected 2nd standard parallel south at a point 9.90 chs E of the standard cor to Tps 10S R35 & 36 E at which point I set a Basalt stone 16x14x9 ins 11 ins in the ground for closing corner to Tps 11S R35 & 36E marked cc with 6 notches on S,E, and W edges and raised a mound of stone along side. Pits impracticable,

retracement survey by K. P. Cecil under group No 99 dated October 1922 Set Basalt stone 18x16x5 ins 13 ins in the ground for closing corner to T11SRs 35½ & 36 E marked CC on S face with 6 notches S,E and W edges I raised a mound of stone S of cor. from the cor.

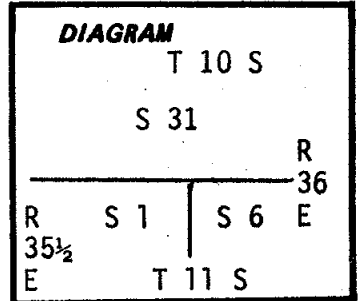

A Fir 16 ins diam., bears S41° 30'E 88 lks dist mkd. CC T11SR 36E S6BT (old markings but newly recorded)

A Pine 26 ins dia., bears S40° W 68 lks dist mkd. CC T11SR 35½E S1BT (old marking but newly recorded.)

A Pine, 22 ins dia., bears N25° W., 5 lks dist., markings on which a illegible in 1974 during a remonumentation project by the B.L.M of certain original corners they found the original stone in place as described and replaced it with a 2½"x28" iron post with a brass cap. They also found

A Fir 24 ins diam bears S41° E., 89 lks dist marked 11E S in partially healed blazes not of record

A Ponderosa Pine 30 ins diam bears S 39° W., 65 lks dist marks not legible in partially sealed blazes not of record.

Description of corner evidence found:

At the corner location I found the brass capped steel pipe as set by the BLM

I also found the three BTs as described by K. P. Cecil in 1922 and the two BTs as described by the B.L.M. in 1974.

A Fir 25" diam. bears. S 41° E 58.1 ft marked 11E,S

A Ponderosa Pine 30" diam, bears. S 40° W 44.9 ft blazes healed over.

The NW BT is partially burned and fell over no visible marks.

Description of monument and accessories established to perpetuate the original location of this corner:

I replaced the NW Bearing Tree with

A 5" White Fir bears N 19° W 12.15 ft marked X BT nail in W. base.

Bearings taken with a staff compass declination 18½° E per 1980 Isogonic chart.

Distances pulled to 60d nails with brass washers stamped LS 1898 driven in the side center of the bearing trees.

Monument Stamped
T10S R36 E
S 31
S1 | S6
R35½E | R36E
T 11 S
CC
1974

REGISTERED
PROFESSIONAL
LAND SURVEYOR
Harry C. Hildebrand
OREGON
JULY 18, 1980
HARRY C. HILDEBRAND
1898

FILED Nov 23, 1982
BAKER COUNTY SURVEYOR
SURVEY NO. 11-35½-1
11-36-1

Office of... Surveyor..... County of... Baker.....
State of... Oregon....., I hereby certify that the within instrument was filed in this office
for record on the..... day of....., 19.....
..... by
(COUNTY OFFICIAL) (DEPUTY)