


**CERTIFIED RECORD OF LAND CORNER MONUMENTATION**

**History of original corner establishment:**

Corner established in 1882 by William R. Gradon, Under General Land Office Contract No. 409. Surveyor Generals Notes State: Set a basalt stone 18x12x8" 12" in the ground for corner to secs. 3,4,9, and 10, marked with 5 notches on S and 3 notches on E edges From which:

- A Pine 6" dia. bears N60°W, 94 lks dist. marked T11S R36E S3 BT.
- A " 22" dia. bears S77°E, 24 lks dist. marked T11S R36E S10 BT.
- A " 40" dia. bears S55°W, 82 lks dist. marked T11S R36E S9 BT.
- A " 30" dia. bears N70°W, 84 lks dist. marked T11S R36E S4 BT.

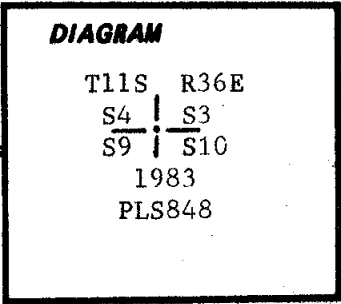

**Description of corner evidence found:**

Found a 16x9x8" stone, set 10" in the ground with 5 grooves on South face and 3 grooves on East face.

From which:

- A live Pine 30" dia. bears N66°W, 57.0 ft. scribed T11S R36E S4 BT.
- A live Pine 12" dia. bears N61°E, 62.3 ft. scribed T11S R36E S3 BT.
- A live Pine 30" dia. bears S77°E, 15.2 ft. scribed T11S R36E S.

Accepted position of stone as section corner.

**Description of monument and accessories established to perpetuate the original location of this corner:**


Set a 30"x2½" aluminum pipe with a 2½" aluminum cap stamped as shown in diagram. Set 20" in the ground and set original stone alongside pipe.

From which:


- An original bearing tree, Pine 30" dia. bears N66°W, 57.0 ft. new scribing S4 BT.
- An original bearing tree, Pine 12" dia. bears N61°E, 62.3 ft. " " S3 BT.
- An original bearing tree, Pine 30" dia. bears S77°E, 15.2 ft. " " S10 BT.
- A new bearing tree, a Pine 10" dia. bears S31°W, 54.8 ft. scribed T11S R36E S9 BT.

Set a steel post with warning sign North 4.0 ft.

Nailed brass washers stamped PLS848, bearing tree and warning signs to each tree. Painted 6" red band around each tree.

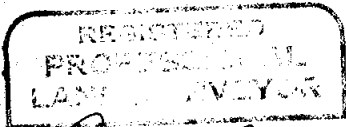

Corner monumented 9-1-83  
Witnessed by Dan Martin

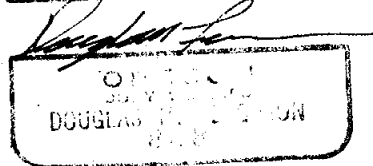

Office of..... County of.....  
State of....., I hereby certify that the within instrument was filed in this office  
for record on the..... day of....., 19.....

..... by .....  
(COUNTY OFFICIAL)

(DEPUTY)