


CERTIFIED RECORD OF LAND CORNER MONUMENTATION

History of original corner establishment:

Corner established in 1882 by William R. Gradon, Under General Land Office Contract No. 409. Surveyor Generals Notes State: Set sandstone 14x10x5 ins., 9" in the ground for corner to secs. 1,2,11, and 12 marked with 5 notches on S and 1 notch on E edges.

From which:

- A Pine 24" dia. bears N65°E, 165 lks dist., marked T11S R36E S1 BT.
- A " 24" dia. bears S40°E, 146 lks dist., marked T11S R36E S12 BT.
- A " 14" dia. bears S65°W, 106 lks dist., marked T11S R36E S11 BT.
- A " 36" dia. bears N38°W, 70 lks dist., marked T11S R36E S2 BT.

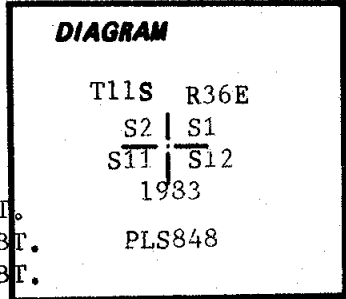

Description of corner evidence found:

Found 16"x10"x5" stone with marks visible faintly, set but lying down.

From which:

- A Pine 30" dia. dead and down scribed T11S R36E S1 BT. bears approx. record N65°E, 108.9 ft.
- A Pine snag 40" dia. 10' high scribed T11S R36E BT bears record N38°W, 46.2 ft., to notch.
- A Pine 20" dia. live scribed T11S R36E, bears S70°W, 69.9 ft., to notch, (record S65°W, 69.9 ft.)
- A Pine live in good condition, 30" dia. with blaze healed over bears S38°E, 97.0 ft. (record S40°E, 96.4 ft.) Accepted stone as section corner position.

Description of monument and accessories established to perpetuate the original location of this corner:

Set a 2½"x30" aluminum pipe with a 2½" aluminum cap stamped as shown in diagram. Set 26" in the ground and set original stone North alongside pipe.

From which:


- A Pine 8" dia. bears N89°W, 22.1 ft. scribed T11S R36E S2 BT.
- A " 14" dia. bears N44°E, 39.9 ft. " T11S R36E S1 BT.
- A " 12" dia. bears S16°E, 48.5 ft. " T11S R36E S12 BT.
- A " 14" dia. bears S26°W, 39.2 ft. " T11S R36E S11 BT.

Set steel post with warning sign North 3 ft.

Nailed brass washers stamped PLS848, bearing tree and warning signs to each tree. Painted 6" red band around each tree.

Corner monumented 9-1-83

Witnessed by Dan Martin

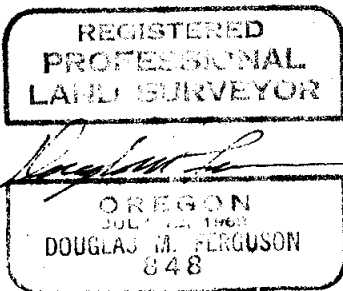

Office of..... County of.....
 State of....., I hereby certify that the within instrument was filed in this office
 for record on the..... day of....., 19.....
 by
 (COUNTY OFFICIAL) (DEPUTY)