

**CERTIFIED RECORD OF LAND CORNER MONUMENTATION**

**History of original corner establishment:**


Corner established in 1882 by William R. Gradon, Under General Land Office Contract No. 409. Surveyor Generals Notes State: Set a basalt stone 18x10x8 ins. 12" in the ground for 1/4 section corner, marked 1/4 on W face. From Which:

A Pine 24" dia. bears S55°E, 12 lks dist., marked 1/4 S BT.  
A " 30" dia. bears S55°W, 17 lks dist., marked 1/4 S BT.

In 1913, while subdividing section 3, H.E. Merryman states:

I began at the 1/4 corner between secs. 3 & 4 which is a basalt stone 6x10x8 ins. above ground marked 1/4 on N face. The charred stub of one witness tree remains with markings destroyed but the letters BT plainly show on the body of the other one which is down. Both distances agree with the original notes but one of the bearings should probably be S65°W. A 24" Pine recently marked 1/4 S US BT, bears S67°20'W, Va 20°E, 64 lks dist, which I marked F.S.

A 30" Pine recently marked US 1/4 S BT, bears S84°10'E, Va 20°E, 29 lks, which I marked F.S.

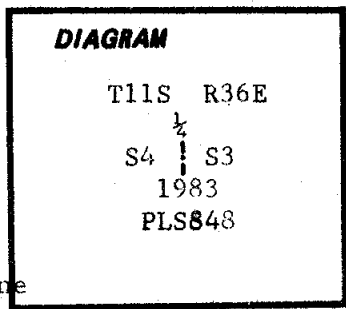

**Description of corner evidence found:**

Found a 18x10x8 ins. stone, set 12" in the ground, marked 1/4 on West face.  
Found remains of bearing trees, conforming with record history.  
Accepted stone as position of 1/4 corner.

**Description of monument and accessories I established to perpetuate the original location of this corner:**

Set a 30"x2 1/2" aluminum pipe with a 2 1/2" aluminum cap stamped as shown in diagram. Set 26" in the ground and set original stone North alongside pipe.

From which:


A Pine 9" dia. bears N82°W, 15.5 ft. scribed 1/4 S4 BT.  
A " 7" dia. bears S55°E, 21.6 ft. " 1/4 S3 BT.

Set steel post with warning sign 4.0 ft. North.

Nailed brass washers stamped PLS848, bearing tree and warning signs to each tree.  
Painted 6" red band around each tree.

Corner monumented 9-1-83

Witnessed by Dan Martin

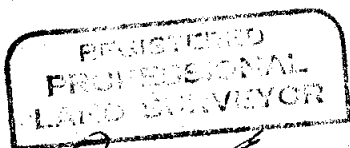

*Douglas G. Gradon*  
Douglas G. Gradon  
649

Office of..... County of.....  
State of....., I hereby certify that the within instrument was filed in this office  
for record on the..... day of....., 19.....  
..... by .....

(COUNTY OFFICIAL)

(DEPUTY)