


UNITED STATES
DEPARTMENT OF THE INTERIOR
BUREAU OF LAND MANAGEMENT
TOWNSHIP DIAGRAM
SCALE: 1 INCH = 1 MILE

TOWNSHIP 11 SOUTH, RANGE 36 EAST, WILLAMETTE MER.
STATE OREGON

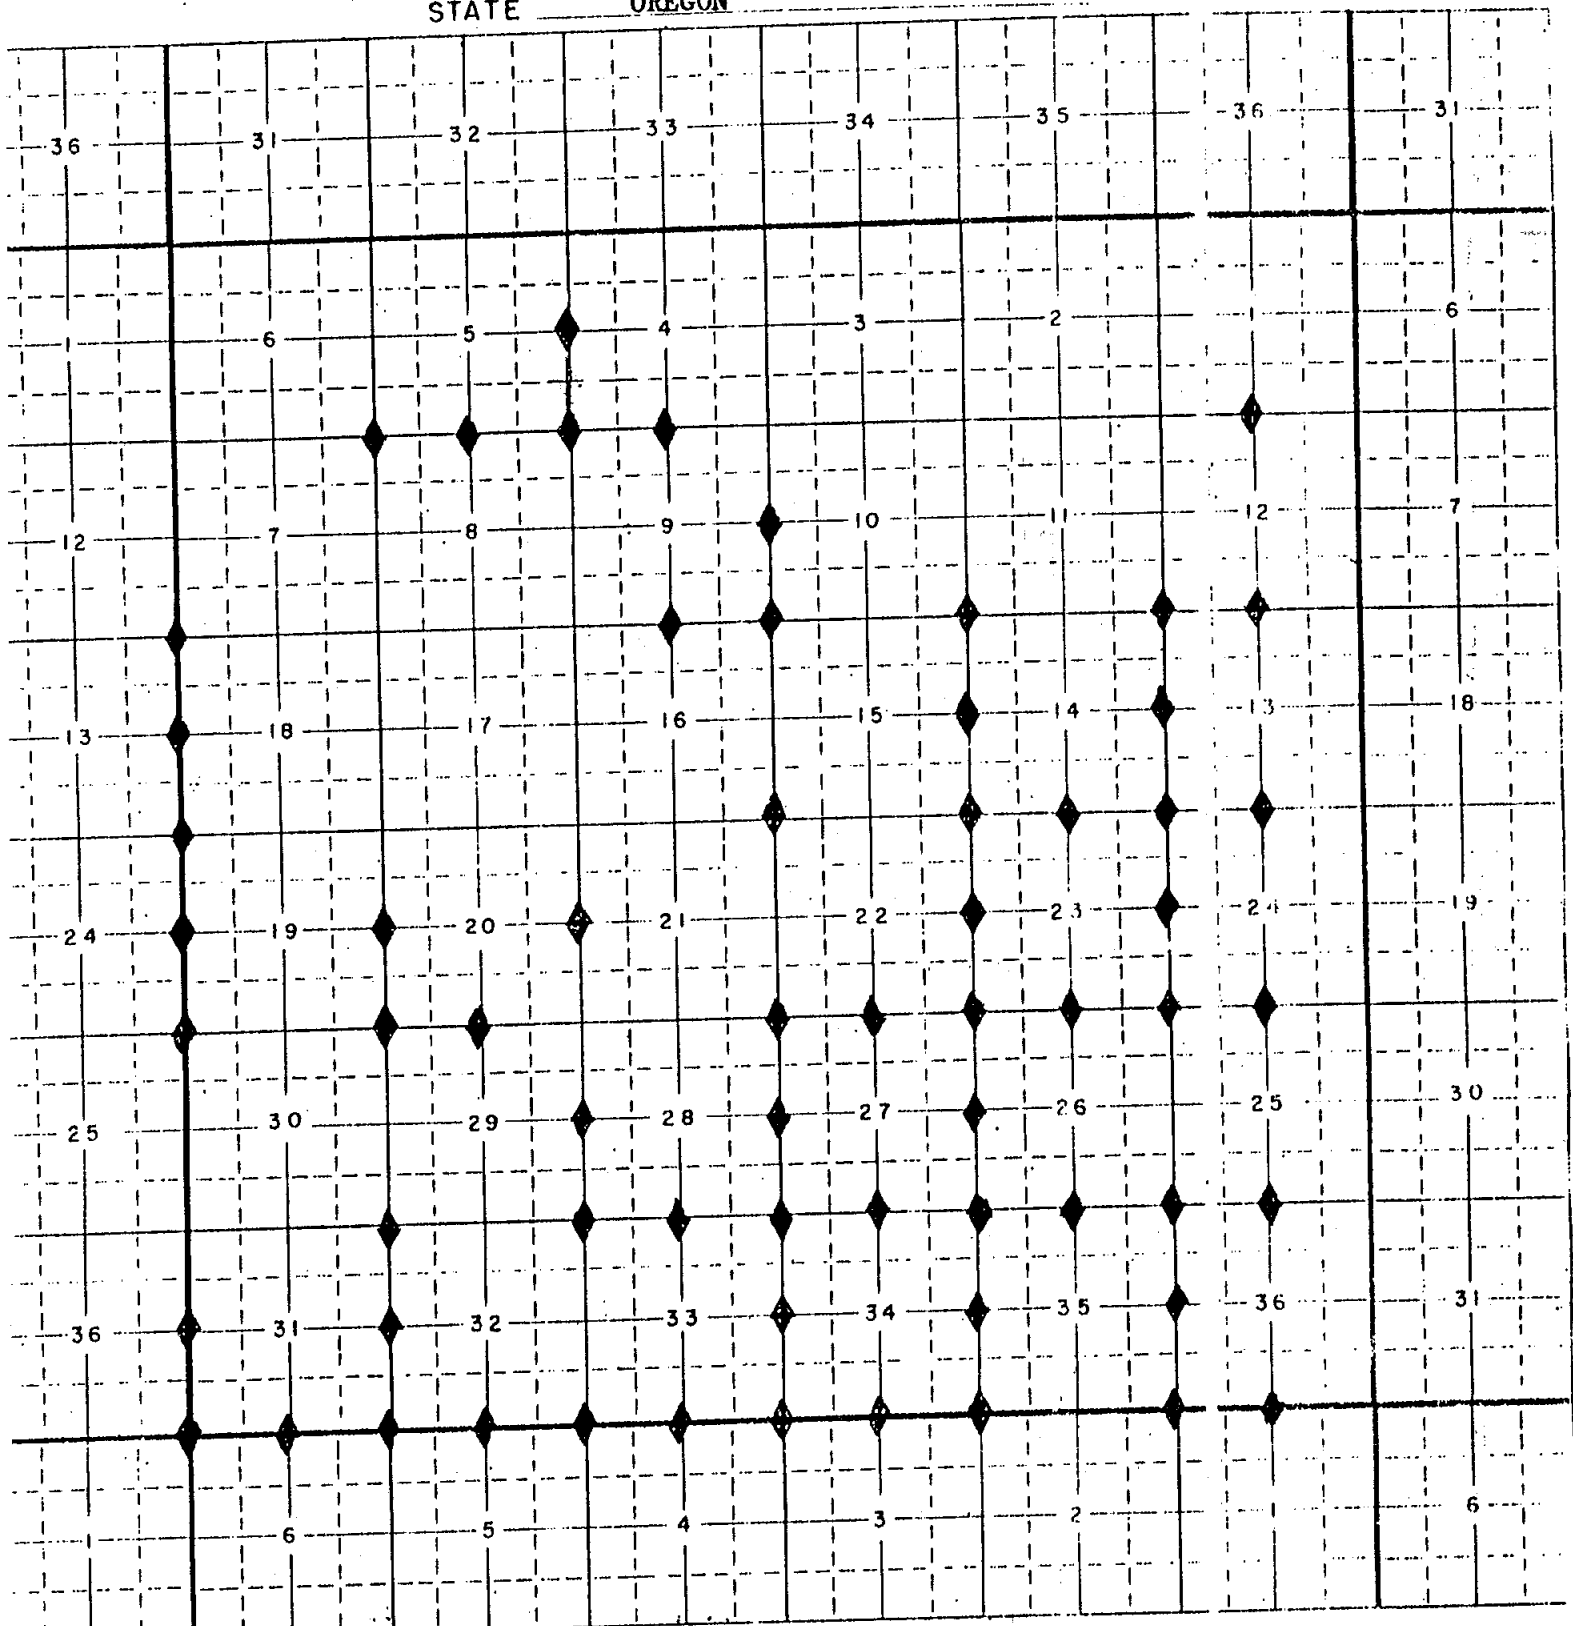

FIELD WORK DONE DURING FISCAL YEAR 1986

BY BUREAU OF LAND MANAGEMENT

OREGON STATE OFFICE

FOR

U.S. FOREST SERVICE, WALLOWA-WHITMAN NATIONAL FOREST

BAKER COUNTY, OREGON

ORIGINAL CORNER MONUMENTED THIS SURVEY - 64 MONUMENTS SET

GROUP 1000, OREGON MONUMENTED BY LEONARD W. MURPHY

FILED 2-19-87
BAKER COUNTY SURVEYOR
SURVEY NO. 11-36-10