

**CERTIFIED RECORD OF LAND CORNER MONUMENTATION**


Sheet 2

V-25

**History of original corner establishment:**

A juniper snag, 10 ins. diam., bears S29°E 63½ lks. dist., with scribe marks T11S R37E S31 BT visible on open blaze. This bearing tree appears similar to corner accessories marked by the original surveyor. At the corner point.

Set a iron post, 28 ins. long 2½ ins. in diam., 10 ins. in the ground, to solid rock, supported in a mound of stone, 4 ft. base, to top, with brass cap marked as shown, from which new bearing trees

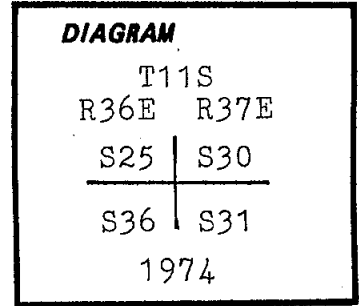

A juniper, 6 ins. diam., bears S36°E 252 lks. dist., mkd. T11S R37E S31 BT.  
A fir, 14 ins. diam., bears S63°W 391 lks. dist., mkd. T11S R36E S36 BT.  
No other trees available within limits.  
Deposit corner stone alongside iron post.

**Description of corner evidence found:**

**Description of monument and accessories | established to perpetuate the original location of this corner:**

REGISTERED  
PROFESSIONAL  
LAND SURVEYOR

*William R. Wells*

OREGON  
JULY 22, 1977  
WILLIAM R. WELLS  
1106

Office of..... County of.....

State of....., I hereby certify that the within instrument was filed in this office for record on the..... day of....., 19.....

..... by .....  
(COUNTY OFFICIAL) (DEPUTY)