

CERTIFIED RECORD OF LAND CORNER MONUMENTATION

Sheet 1

Z-25


History of original corner establishment:

Corner was originally established by Eugene P. Mc Cornack, U.S. Deputy Surveyor, under his Contract No. 398, dated July 2, 1881.

Surveyor General record states:

Set post 4 1/2 ft long 4 ins. square 24 ins. in the ground for cor to Tps 11 and 12 S R s 36 and 37 E marked T 11S S 31 on NE, R37E S 6 on SE, T12S S1 on SW and R 36E S36 on NW, with 6 notches on each edge from which:

- A pine 36 ins diam bears N20°E 33 lks dist marked T11S R37E S31 BT.
- A pine 24 ins. diam bears S82½°E 70 lks dist marked T12S R37E S 6 BT.
- A pine 12 ins diam bears S62½°W 109 lks dist marked T12S R36E S 1 BT.
- A pine 24 ins diam bears N3°W 75 lks dist marked T11S R36E S36 BT.

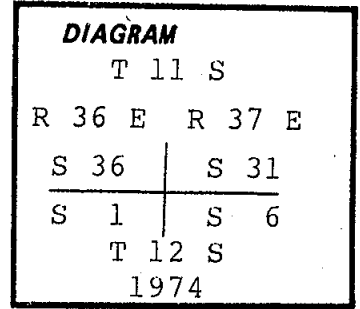

Corner was remonumented by BLM in 1974. Cont. on Sheet 2

Description of corner evidence found:

Found 2½" iron pipe with 3¼" brass cap marked as shown in corner diagram firmly set in stone mound from which: Root hole brs N20°E, 21.8', and root hole brs S82½°E, 46.2' both with remains of uprooted & burnt stumps alongside with no scribing. P pine stump 15" brs N87°W, 49.5' with visible scribing. P pine stump brs N40°E, 4.6'. BT (8") is lying on ground with scribes. P pine stump brs S54°E, 8.6' BT (7") is down with visible scribing. D fir 15" brs S57½°W, 45.5' with healed blaze. P pine stump brs N17°W, 10.3'. BT (9") is down with visible scribing.

Note: The first three bearing tree calls are to the original bearing trees and the remaining four calls are to the BLM bearing trees from the 1974 remonumentation.

Description of monument and accessories I established to perpetuate the original location of this corner:

MAINTAINED corner by improving surrounding stone mound, firmly setting fence post to which sign 54-9 is attached, repainting blaze and band with red paint on all BTs, and attaching signs 54-9 & 54-3 to BTs.

New bearing trees established:

- P pine 15" dia brs N22 3/4°W, 20.3' marked T11SR36ES36 BT.
- P pine 8" dia brs N20¼°E, 54.6' marked T11SR37ES31 BT.
- P pine 10" dia brs S79°E, 37.0' marked T12SR37ES6 BT.

New bearing trees have a brass washer stamped PLS 1106 nailed to face of blaze. Attached signs 54-3 & 54-9 and painted face of blaze and a 6" band of red around each BT. Set steel fence post South of corner and attached sign 54-9.

Compass declination 19° East.

I hereby certify that the above corner monument was properly maintained to U.S.F.S. standards under my supervision and witnessed by Scott Munro on May 27, 1987.

REGISTERED
PROFESSIONAL
LAND SURVEYOR

William R. Wells

OREGON
JULY 22, 1977
WILLIAM R. WELLS
1106

Office of.....County Surveyor..... County of... Baker.....

State of... Oregon....., I hereby certify that the within instrument was filed in this office for record on the..... day of....., 19.....

..... by
(COUNTY OFFICIAL) (DEPUTY)