


CERTIFIED RECORD OF LAND CORNER MONUMENTATION

Sheet 2

Z-25

History of original corner establishment: BLM record states:
The cor. of Tps 11 and 12 S., Rs 36 and 37 E.,
monumented with the decayed remains of the original
wood post, size indeterminate, from which the remains
of the original bearing trees:

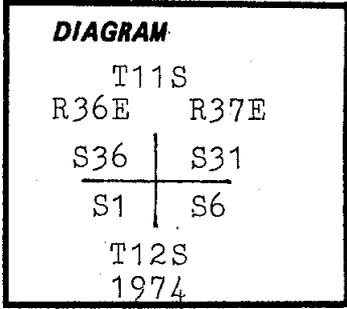

A root hole bears N20°E., 33 lks dist.
A root hole, bears S82½°E., 70 lks. dist., with a
down and decayed ponderosa pine alongside, 24 ins.
diam., no marks visible.
A root hole, bears S. 62½°W., 109 lks. dist.
A ponderosa pine stump, 24 ins. diam., bears N. 87°W., 75 lks. dist., with
scribe marks T11S R36E S36 BT visible on open double blaze. (Record N.3°W.).

At the corner point
Set an iron post, 28 ins. long, 2½ ins. diam., 18 ins. in the ground, and
in a mound of stone, 1½ ft. base, to top, with brass cap mkd as shown, from

Description of corner evidence found:

XXXXXXXXXXXXXXXXXXXXXXXXXXXXX
which new bearing trees
A ponderosa pine, 8 ins. diam., bears N40°E., 7 lks. dist., mkd. T11S R37E S31
BT.
A ponderosa pine, 7 ins. diam., bears S. 54°E., 13 lks. dist., mkd T12S
R37E S6 BT.
A fir, 9 ins. diam., bears S. 57½°W., 69 lks dist., mkd. T12S R36E S1 BT.
A ponderosa pine, 9 ins. diam., bears N. 17°W., 15½ lks. dist., mkd. T11S
R36E S36 BT.
Deposit remains of wood post alongside iron post.

**Description of monument and accessories | established to perpetuate the
original location of this corner:**

REGISTERED PROFESSIONAL LAND SURVEYOR
<i>William R. Wells</i>
OREGON JULY 22, 1977 WILLIAM R. WELLS 1106

Office of..... County of.....
State of....., I hereby certify that the within instrument was filed in this office
for record on the..... day of....., 19.....
..... by
(COUNTY OFFICIAL) (DEPUTY)