


CERTIFIED RECORD OF LAND CORNER MONUMENTATION

W-25

History of original corner establishment:

None. Corner established with this survey.

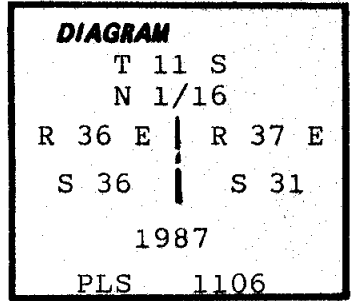

Description of corner evidence found:

None.

Description of monument and accessories I established to perpetuate the original location of this corner:

At position established by survey...

Set a 2½" x 30" aluminum pipe with 2½" aluminum cap 20" in ground and surrounded with mound of earth and stone. Cap marked as shown in corner diagram.

Now bearing trees established:

A 7" juniper brs S3°E, 49.5' scribed N1/16S31 BT.

A 11" ponderosa pine brs S79½°W, 19.7' scribed N1/16S36 BT.

Now bearing trees have a brass washer stamped PLS 1106 nailed to face of blaze. Attached signs 54-3 & 54-9 and painted face of blaze and a 6" band of red around each BT. Set steel fence post South of corner and attached signs 54-2 & 54-9.

Compass declination 19° East.

I hereby certify that the above corner monument was properly established to U.S.F.S. standards by me on November 4, 1987.

REGISTERED PROFESSIONAL LAND SURVEYOR

William R. Wells

OREGON JULY 22, 1977 WILLIAM R. WELLS 1106

Office of..... County Surveyor..... County of..... Baker
 State of..... Oregon....., I hereby certify that the within instrument was filed in this office
 for record on the..... day of....., 19.....
 by
 (COUNTY OFFICIAL) (DEPUTY)

FILED 1-21-88
 BAKER COUNTY SURVEYOR
 SURVEY NO. 11-36-14