


CERTIFIED RECORD OF LAND CORNER MONUMENTATION

Y-25

**History of original corner establishment:**

None. Corner established with this survey.

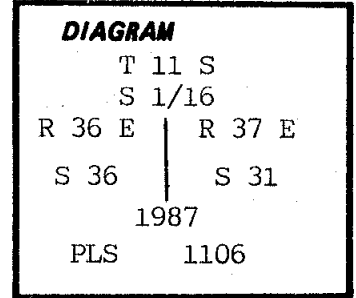

**Description of corner evidence found:**

None.

**Description of monument and accessories established to perpetuate the original location of this corner:**

At position established by survey...

Set 2½" x 30" aluminum pipe with 2½" aluminum cap 8" in ground to bedrock and surrounded with a mound of earth and stone. Cap marked as shown in corner diagram.

New bearing trees established:

A 6" ponderosa pine brs N5½°E, 31.0' dist mkd S1/16S31 BT.

A 7" juniper brs N36½°W, 21.1' dist mkd S1/16S36 BT.

New bearing trees have a brass washer stamped PLS 1106 nailed to face of blaze. Attached signs 54-3 & 54-9 and painted face of blaze and a 6" band of red around each BT. Set steel fence post North of corner and attached sign 54-9 and 54-2.

Compass declination 19° East.

I hereby certify that the above corner monument was properly established to U.S.F.S. standards under my supervision November 2, 1987.

REGISTERED PROFESSIONAL LAND SURVEYOR
---

*William R. Wells*

OREGON JULY 22, 1977 WILLIAM R. WELLS 1106
---

Office of..... County Surveyor..... County of..... Baker.....

State of..... Oregon..... I hereby certify that the within instrument was filed in this office

for record on the..... day of....., 19.....

..... by .....

(COUNTY OFFICIAL)

(DEPUTY)