


CERTIFIED RECORD OF LAND CORNER MONUMENTATION

INDEX No. A-15

**History of original corner establishment:**

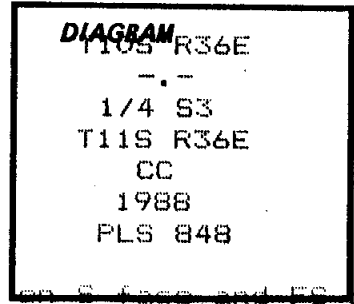

Corner was originally established by H.E. Merryman, in 1913 while performing a Forest Boundary Survey for the U.S. Forest Service. The Notes from that Survey State: Intersected Second Standard Parallel South where I set a basalt stone 24x12x8 15 inches in the ground marked 1/4 CC on S face and FS on N face, 81 lks. West of road, and 7.87-1/2 chs. East of Standard 1/4 corner 1 Sec. 34, T10S., R.36E., W.M., for the closing 1/4 corner to Section 3, where W on corner post in fence bears n.7-1/2° W., Va.20° E., 127 lks. 1/4 CC BR on rock in place 18x18 inches, 18 inches high bears N.49-1/2° E. 108lks. X FS BR on rock in place 18x14 inces, 24 inches high, bears N81-1/2° E., 153 lks.

**Description of corner evidence found:**

Found 24"x12"x10" stone, set vert. in the ground, with 1/4 CC FS on the South face, as set by H.E. Merryman in 1913. Corner was not established in the original GLO Survey. There are none of Merryman's accessories positively identified. Accepted the above described stone as the Closing Corner as a properly established corners as set by Merryman in 1913. The Corner is found to be N 0°13'35"E., 4.06 from the true Township Line.

**Description of monument and accessories I established to perpetuate the original location of this corner:**

Set 2-1/2"x30" aluminum pipe with 3-1/2" aluminum cap, stamped as shown on the **DIAGRAM**, SET 28" in the ground. From Which: (Original Stone is left in position as set by Merryman) Set 5/8"x30" iron pins, with plastic caps Marked PLS 848 and metal guard posts driven alongside, with Warning Signs and Bearing Tree Signs wired to each post. Measurements taken to plastic caps as follows: S43°30'E., 10.0 ft. and S40°25'W., 10.0 ft. Measurements to pins taken with an Electronic Tacheometer with Bearing: turned from the survey control network.

**REGISTERED PROFESSIONAL LAND SURVEYOR**

*[Signature]*  
**OREGON**  
JULY 12, 1908  
**DOUGLAS M. FERGUSON**  
848

This work is performed by:  
Douglas M. Ferguson PLS 848  
Mt. Vernon Oregon.  
On: Aug. 10, 1988  
Refer to Map of Survey No. 11-36-17  
Witnesses: D. Mitchell Ferguson & Ken Delano

Office of..... County of.....  
State of....., I hereby certify that the within instrument was filed in this office  
for record on the..... day of....., 19.....  
..... by .....  
(COUNTY OFFICIAL) (DEPUTY)