


CERTIFIED RECORD OF LAND CORNER MONUMENTATION

INDEX No. A-17

History of original corner establishment:

Corner was originally established by WM.R. Gradon, in March 1882, under General Land Office Contract No. 409. The U.S. Surveyor Generals Notes State: 66.27 Ch., Intersect 2nd Standard Parallel South, at a point 8.00 chs E. of the Standard Cor to Secs 34 & 35, T10S R36E;

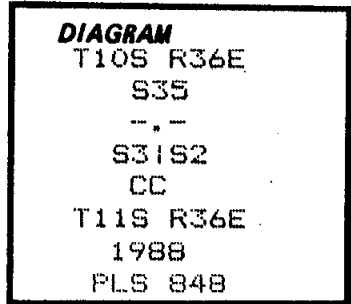

Set a post 4 ft. long, 4 ins square with marked stone, 12 ins in the ground for closing cor. to Secs 2 & 3, marked CC T11S R36E on S., S2 on E and S3 on W. faces, with 2 notches on E and 4 notches on W. faces, dug pits 18x18x12 ins, S & W of post 5-1/2 ft dist and raised a mound of earth, 2 ft. high, 4-1/2 ft. base around post.

Description of corner evidence found:

No trace of the original post, pits or mounds is remaining at this corner.


There are no accessories originally established at this corner, except the pits and mounds. I determined this corner to be lost due to parishable monument material, and reestablished to position at proportionate measure between the Standard Corner to Sections 34/35 and the Standard 1/4 Corner of Section 35, as established by McCornack, in 1881 and the falling as recorded by W. Gradon in 1882 when he established this corner.

Description of monument and accessories I established to perpetuate the original location of this corner:

Set 2-1/2"x30" aluminum pipe with 3-1/2" aluminum cap, stamped as shown on the **DIAGRAM**, SET 29" in the ground.

From Which:

Set 5/8"x30" iron pins, with plastic caps Marked PLS 848 and metal guard posts driven alongside, with Warning Signs and Bearing Tree Signs wired to each post. Measurements taken to plastic caps as follows: S46°21'E., 10.0 ft. and S40°20'W., 10.0 ft. Measurements to pins taken with an Electronic Tacheometer with Bearing turned from the survey control network.

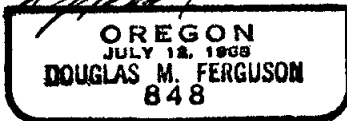

This work is performed by:
Douglas M. Ferguson PLS 848
Mt. Vernon Oregon.
On: Aug. 10, 1988
Refer to Map of Survey No. 11-36-17
Witnesses: D. Mitchell Ferguson & Ken Delano

Office of..... County of.....
State of....., I hereby certify that the within instrument was filed in this office
for record on the..... day of....., 19.....
..... by
(COUNTY OFFICIAL) (DEPUTY)