


CERTIFIED RECORD OF LAND CORNER MONUMENTATION

INDEX No. C-15

History of original corner establishment:

Corner was originally established by H.E. Merryman, in 1913 while performing a Forest Boundary Survey for the U.S. Forest Service. The Notes from that Survey State: Intersected my line between the N. and S. halves of Sec. 3. at 39.78 chains from the E.1/4 corner where I set a basalt stone 20x10x6 inches, 12 inches in the ground, marked C/3 FS on W. face, for center Sec. 3, whence
xC/3 FS BR on rock in place 3x3 feet, 2 feet high, bears N35-1/2°W, 3 lks.
xC/3 FS BR on rock in place 18x18 inches, 18 inches high, bears S27-1/4°E Va. 20°E. 142 lks.
xC/3 FS BT on 28 inch pine bears n.35-1/2°E., Va.20°E. 139 lks.

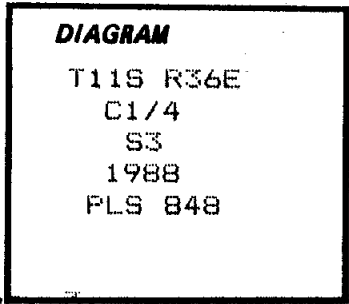

Description of corner evidence found:

Found 18 x 12 x 12 stone with C3 visible on West face & FS on East face, as properly established by H.E. Merryman, in 1913. (Stone set vert in the ground)

None of the accessories as described by Merryman are positively identified. Accepted the above described stone as the Center 1/4 of Section 3.

Description of monument and accessories I established to perpetuate the original location of this corner:

Set 2-1/2" x 30" aluminum pipe with 3-1/2" aluminum cap, stamped as shown on the **DIAGRAM**, SET 8" in the ground and raised a 24" high x 48" dia., mound of stone & earth around the pipe.

From Which:

A Ponderosa Pine 18" dia., Bears N73°21'W., 70.7 ft., scribed: C1/4 S3 BT
A Ponderosa Pine 14" dia., Bears S44°02'W., 99.5 ft., scribed: C1/4 S3 BT
Measurements to trees taken with an Electronic Tacheometer with Bearings turned from the survey control network.

Nailed a brass washer stamped PLS 848 on blaze above BT scribe, Bearing Tree Sign above blaze, and warning sign on back of each tree. Painted a 6" red band at breast ht. around each tree. Set steel fence posts with warning & Boundary Signs, in stone mound around pipe, North & West 1 ft. from the corner.

**REGISTERED
PROFESSIONAL
LAND SURVEYOR**

[Signature]
**OREGON
JULY 12, 1969
DOUGLAS M. FERGUSON
848**

This work is performed by:
Douglas M. Ferguson PLS 848
Mt. Vernon Oregon.
On: Aug. 8, 1988
Refer to Map of Survey No. 11-36-17
Witnesses: D. Mitchell Ferguson & Ken Delano

Office of..... County of.....
State of....., I hereby certify that the within instrument was filed in this office
for record on the..... day of....., 19.....

..... by
(COUNTY OFFICIAL) (DEPUTY)