


CERTIFIED RECORD OF LAND CORNER MONUMENTATION

INDEX No. C-16

History of original corner establishment:

Corner was originally established by H.E. Merryman, in 1913 while performing a Forest Boundary Survey for the U.S. Forest Service. The Notes from that Survey State: For corner B, Sec.3, 19.89 chs. from the center of the section and from the E.1/4 corner, I set a basalt stone 27x7x3 inches, 12 inches in earth and stone, marked 1/16 B on W. face and FS on S. face, whence
x1/16 FS BR on rock 8x8feet 5 feet high, bears S27-1/2°E, Va. 20°E 72 lks.

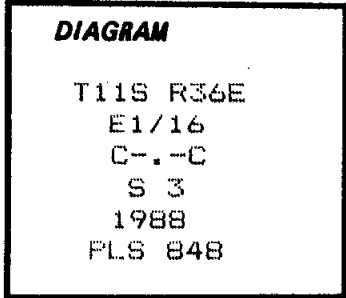

1/16 FS BR on 12 inch pine, bears N 16-1/2°E., 334 lks.

Description of corner evidence found:

Found 27"x7"x3" stone with 1/16 B on West face & FS on South face, set vertical and solid in the ground as established by Merryman in 1913.

Found the 8'x8'x5' stone at approx. measurement as shown in Merrymans notes.

Accepted the above described stone as the C-E 1/16 corner as properly established by Merryman.

Description of monument and accessories I established to perpetuate the original location of this corner:

Set 2-1/2"x30" aluminum pipe with 3-1/2" aluminum cap, stamped as shown on the **DIAGRAM**, SET 10" in the ground, set original stone North alongside pipe and raised a mound of stone around the pipe.

From Which:

A Ponderosa Pine 10" dia., Bears S55°20'W., 23.5 ft., scribed: CE 1/16 S3 BT

A Ponderosa Pine 8" dia., Bears S 6°37'E., 29.6 ft., scribed: CE 1/16 S3 BT

Measurements to trees taken with an Electronic Tacheometer with Bearings turned from the survey control network.

Nailed a brass washer stamped PLS 848 on blaze above BT scribe, Bearing Tree Sign above blaze, and warning sign on back of each tree. Painted a 6" red band at breast ht. around each tree. Set steel fence posts with warning & Boundary Signs, North and East 3 ft. from the corner.

**REGISTERED
PROFESSIONAL
LAND SURVEYOR**

[Signature]
**OREGON
JULY 12, 1969
DOUGLAS M. FERGUSON
848**

This work is performed by:
Douglas M. Ferguson PLS 848
Mt. Vernon Oregon.
On: Aug. 9, 1988
Refer to Map of Survey No. 11-36-17
Witnesses: D. Mitchell Ferguson & Ken Delano

Office of..... County of.....
State of....., I hereby certify that the within instrument was filed in this office
for record on the..... day of....., 19.....

..... by
(COUNTY OFFICIAL) (DEPUTY)