


**CERTIFIED RECORD OF LAND CORNER MONUMENTATION**

INDEX No. C-19

**History of original corner establishment:**

Corner was originally established by H.E. Merryman, in 1913 while performing a Forest Boundary Survey for the U.S. Forest Service. The Notes from that Survey State: Intersected N. line S.1/2 Sec. 2 at S89°27'E., 40.46 from W.1/4 corner Sec. 2, where I set a basalt stone 26x8x5 inches, 14 inches in the ground, marked C/2 on S. face and FS on N. face, for center of fraction Sec. 2. whence:  
 C2 FS BT on 16 inch Yellow pine, bears N54°E., Va.20°E., 20 lks  
 C2 FS BT on 10 inch Yellow pine, bears N76°W., 75 lks  
 xC2 FS BR on top of boulder 24x18 inches, 6 inches high, bears N84-1/2°W. 17 lks  
 x BR on ledge of rock 4x7 feet, 2-1/2 feet high, bears S41-1/2°E., 108 lks.

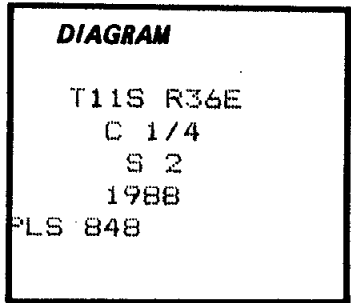

**Description of corner evidence found:**

Found 26"x10"x5" stone set in a mound of stone, with F visible on the South face, as established by Merryman, in 1913

**From Which:**

Found a Ponderosa Pine 20" dia., bears N61°E., 13.9 ft, with scribing visible reads: C2 F, as called for by Merryman, (His notes call N54°E., 13.2)

Accepted the above described stone as the Center 1/4 Section 2, as properly established by Merryman in 1913

**Description of monument and accessories established to perpetuate the original location of this corner:**

Set 2-1/2"x30" aluminum pipe with 3-1/2" aluminum cap, stamped as shown on the **DIAGRAM**, SET 18" in the ground, set the original stone North alongside pipe and raised a mound of stone around the pipe.

**From Which:**

A Ponderosa Pine 8" dia., Bears N38°38'W., 9.8 ft., scribed: C1/4 S2 BT  
 A Ponderosa Pine 10" dia., Bears N53°02'E., 34.1 ft., scribed: C1/4 S2 BT  
 Measurements to trees taken with an Electronic Tacheometer with Bearings turned from the survey control network.

Nailed a brass washer stamped PLS 848 on blaze above BT scribe, Bearing Tree Sign above blaze, and warning sign on back of each tree. Painted a 6" red band at breast ht. around each tree. Set steel fence post with warning Sign, North 4 ft. from the corner.

**REGISTERED  
 PROFESSIONAL  
 LAND SURVEYOR**

**OREGON  
 JULY 12, 1988  
 DOUGLAS M. FERGUSON  
 848**

This work is performed by:  
 Douglas M. Ferguson PLS 848  
 Mt. Vernon Oregon.  
 On: Aug. 9, 1988  
 Refer to Map of Survey No. 11-36-17  
 Witnesses: D. Mitchell Ferguson & Ken Delano

Office of..... County of.....  
 State of....., I hereby certify that the within instrument was filed in this office  
 for record on the..... day of....., 19.....

..... by .....

(COUNTY OFFICIAL)

(DEPUTY)

FILED 3-30-89  
 BAKER COUNTY SURVEYOR  
 SURVEY NO. 11-36-28