


CERTIFIED RECORD OF LAND CORNER MONUMENTATION

INDEX No. Z-15

History of original corner establishment:

Corner was originally established by Eugene P. McCornack in 1881, under General Land Office Contract No. 389. The U.S. Surveyor Generals Notes State: Set Post 3 ft. long, 3 ins. Square with marked stone 12 ins in ground for 1/4 Sec. Cor. marked SC 1/4 on N face. Dug pits 18x18x12

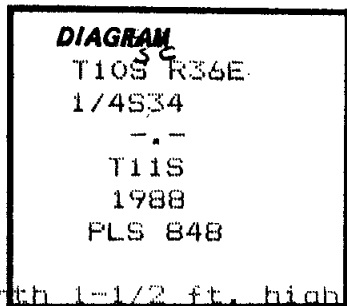

ins. E&W of post, 5 ft. dist and raised a mound of earth 1-1/2 ft. high 3-1/2 ft. base around post. In 1913, H.E. Merryman's notes State: Since the Standard 1/4 corner to Sec. 34 was obliterated I restored it by placing it in line with marks of the Government survey in timber on either side of the Burnt River bottom and 163 lks. E of Burnt River, where I set a basalt stone 16x12x4 inches, 12 inches in the ground, marked 1/4SC on N. face and FS on S. face, whence 1/4 SC FS BT on dead lodgepole pine 20 in. diameter, bears S55-1/2°E., Va. 20°E., 280 lks. (See Survey 11-36-18)

Description of corner evidence found:

Found 16"x12"x4" Stone set vertical with "1/4" visible on North face and "FS" visible on South face. This is the reestablishment by H.E. Merryman, in July, 1913 of an obliterated corner as established in 1881.

No trace of the Post, Pits, or mounds as set by Eugene McCornack in 1881. There where no accessories originally established. No trace of the accessories established by Merryman.

Accepted the above described stone as a proper perpetuation of the original corner.

Description of monument and accessories I established to perpetuate the original location of this corner:

Set 2-1/2"x30" aluminum pipe with 3-1/2" aluminum cap, stamped as shown on the **DIAGRAM**, SET 28" in the ground, with above described stone North alongside the pipe.

From Which:

Set 5/8"x30" iron pins, with plastic caps Marked PLS 848 and metal guard posts driven alongside, with Warning Signs and Bearing Tree Signs wired to each post. Measurements taken to plastic caps as follows: N44°58'E., 10.0 ft. and N46°15'W., 10.0 ft. Measurements to pins taken with an Electronic Tachoemeter, with Bearings turned from the survey control network.

**REGISTERED
PROFESSIONAL
LAND SURVEYOR**

[Signature]
**OREGON
JULY 12, 1966
DOUGLAS M. FERGUSON
848**

This work is performed by:
Douglas M. Ferguson PLS 848
Mt. Vernon Oregon.
On: Aug. 10, 1988
Refer to Map of Survey No. 11-36-17
Witnesses: D. Mitchell Ferguson & Ken Delano

Office of..... County of.....
State of....., I hereby certify that the within instrument was filed in this office
for record on the..... day of....., 19.....
..... by
(COUNTY OFFICIAL) (DEPUTY)

FILED 3-30-89
BAKER COUNTY SURVEYOR
SURVEY NO. 11-36-30