


**CERTIFIED RECORD OF LAND CORNER MONUMENTATION**

INDEX No. Z-23

**History of original corner establishment:**

Corner was originally established in 1881, by Eugene P. McCornack, under General Land Office Contract No. 398. In 1974, the Bureau of Land Management Remonumented this corner as based on the recovery of original evidence. Such remonumentation is shown in the official BLM Notes, Titled "REMONUMENTATION OF CERTAIN ORIGINAL CORNER POINTS, TOWNSHIP 10 SOUTH, RANGE 36 EAST. Work was executed by: Lester E. Fischer, Cadastral Surveyor, Under special instructions dated May 3, 1957, approved May 6, 1957, under U.S. Survey/Group Number 350, and assignment instructions dated Sept. 13, 1974.

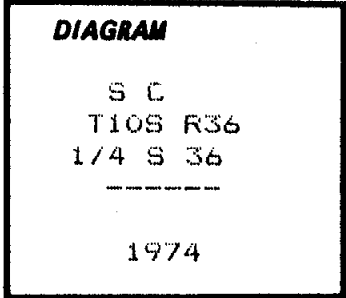

**Description of corner evidence found:**

Found 2-1/2" iron pipe with 3" brass cap stamped as shown in the DIAGRAM, set in a mound of stone.

Found Bearing Trees as established and described by the Bureau of Land Management, the Northwest of which is in good condition with the proper signs. The Northeast is dead.

**Description of monument and accessories | established to perpetuate the original location of this corner:**

Added stones to the mound and placed in proper solid condition.

**From Which:**

Painted a 6" red band at breast ht. around the Bearing Trees as taken by the (New Bearing Tree)  
Ponderosa Pine 6" dia., Bears N10°42'E., 38.8ft., scribed: SC 1/4 S36 BT  
Measurements to trees taken with Electronic Tacheometer with bearings turned from the survey control network.  
Nailed a brass washer stamped PLS 848 on blaze above BT scribe, Bearing Tree Sign above blaze, and warning sign on back of new tree. Painted a 6" red band at breast ht. around new tree.

**REGISTERED  
PROFESSIONAL  
LAND SURVEYOR**

**OREGON  
JULY 12, 1903  
DOUGLAS M. FERGUSON  
848**

This work is performed by:  
Douglas M. Ferguson PLS 848  
Mt. Vernon Oregon.  
On: Oct. 14, 1988  
Refer to Map of Survey No. 11-36-17  
Witnesses: D. Mitchell Ferguson & Ken Delano

Office of..... County of.....  
State of....., I hereby certify that the within instrument was filed in this office  
for record on the..... day of....., 19.....  
..... by .....  
(COUNTY OFFICIAL) (DEPUTY)

**FILED** 3-30-89  
**BAKER COUNTY SURVEYOR**  
**SURVEY NO. 11-36-31**