


**CERTIFIED RECORD OF LAND CORNER MONUMENTATION**

INDEX No. A-15 AM  
History of original corner establishment:

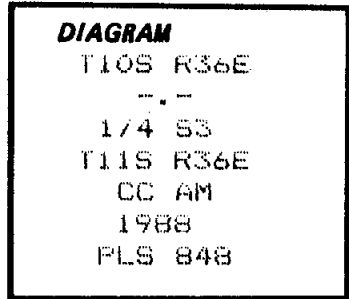


Corner was originally established by H.E. Merryman, in 1913 while performing a Forest Boundary Survey for the U.S. Forest Service. The Notes from that Survey State: Intersected Second Standard Parallel South where I set a basalt stone 24x12x8 15 inches in the ground marked 1/4 CC on S face and FS on N face, 81 lks. West of road, and 7.87-1/2 chs. East of Standard 1/4 corner 1 Sec. 34, T10S., R.36E., W.M., for the closing 1/4 corner to Section 3, where W on corner post in fence bears n.7-1/2° W., Va.20° E., 127 lks. 1/4 CC BR on rock in place 18x18 inches, 18 inches high bears N.49-1/2° E. 108lks. X FS BR on rock in place 18x14 inches, 24 inches high, bears N81-1/2° E., 153 lks.

**Description of corner evidence found:**

Found 24"x12"x10" stone, set vert. in the ground, with 1/4 CC FS on the South face, as set by H.E. Merryman in 1913. Corner was not established in the original GLO Survey. There are none of Merryman's accessories positively identified. Accepted the above described stone as the Closing Corner as a properly established corners as set by Merryman in 1913. The Corner is found to be N 0°13'35"E., 4.06 from the true Township Line. Monumented the above described stone, in its original position.

**Description of monument and accessories | established to perpetuate the original location of this corner:**

Set 2-1/2"x30" aluminum pipe with 3-1/2" aluminum cap, stamped as shown on the **DIAGRAM**, SET 26" in the ground and set the original stone North, alongside the pipe.  
From Which:  
Set 5/8"x30" iron pins, with plastic caps Marked PLS 848 and metal guard posts driven alongside, with Warning Signs and Bearing Tree Signs wired to each post. Measurements taken to plastic caps as follows: S30°00'E., 13.3 ft. and S26°50'W., 13.3 ft. Measurements to pins taken with an Electronic Tacheometer with Bearings turned from the survey control network. The same Pins are used for both this Amended cor. and the True Cor.

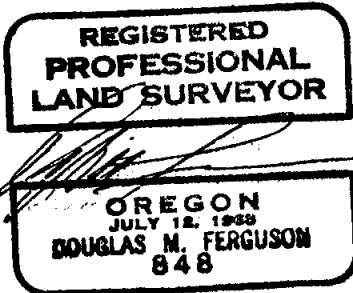

This work is performed by:  
Douglas M. Ferguson PLS 848  
Mt. Vernon Oregon.  
On: Sept. 15, 1988  
Refer to Map of Survey No. 11-36-17  
Witnesses: D. Mitchell Ferguson & Ken Delano

Office of..... County of.....  
State of....., I hereby certify that the within instrument was filed in this office  
for record on the..... day of....., 19.....  
..... by .....  
(COUNTY OFFICIAL) (DEPUTY)