

CERTIFIED RECORD OF LAND CORNER MONUMENTATION

Y-25

History of original corner establishment:

Corner originally established in 1987 by William R. Wells, PLS 1106, under U.S. Forest Service contract. Well's record states:

At position established by survey...

Set 2½" x 30" aluminum pipe with 2½" aluminum cap 8" in ground to bedrock and surrounded with a mound of earth and stone. Cap marked as shown in corner diagram.

New bearing trees established:

A 6" ponderosa pine brs N5½°E, 31.0' dist mkd S1/16S31 BT.

A 7" juniper brs N36½°W, 21.1' dist mkd S1/16S36 BT.

New bearing trees have a brass washer stamped PLS 1106 nailed to face of blaze. Attached signs 54-3 & 54-9 and painted face of blaze and a 6" band of red around each BT. Set steel fence post North of corner and attached sign 54-9 and 54-2.

Compass declination 19° East.

Description of corner evidence found:

Found a 2½" aluminum cap on aluminum pipe marked as shown in corner diagram, 22" above ground in large stone mound.

From Which:

A Ponderosa Pine dead and down, bears N5½°E, 31.0' with visible scribing.

A Juniper 10" in diameter, bears N36½°W, 21.1' with visible scribing.

Steel fence post with 54-2 and 54-9 signs bears north, 6.9'.

Description of monument and accessories I established to perpetuate the original location of this corner:

Establish new bearing tree:

A Juniper 7" in diameter, bears N28°E, 10.1' scribed X BT.

Distance to new bearing tree measured to 60d spike in right side center. Bearing tree has a brass disk stamped PLS 2672 nailed between the B and T on lower face. Bearing tree has a 54-3 and a 54-9 sign, a 6" red painted band, and bearing tree face painted red.

Set an aluminum fence post 10.6' south of corner with a 54-2 sign.


Geodetic Coordinates (NAD83):

N 44°33'48.5"
W 118°13'54.4"

Geodetic coordinates were obtained from a Garmin recreational grade GPS receiver and were averaged.

Date: June 30, 2014
Declination: 14½°E
Witness: Dan Lee

REC'D Oct. 23, 2014
BAKER COUNTY SURVEYOR
SURVEY NO. 11-36-35
11-37-155

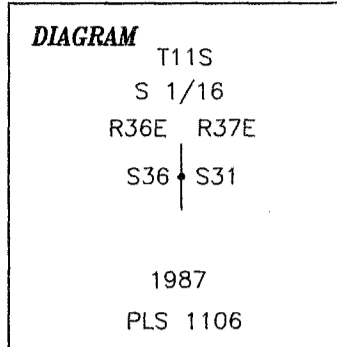

REGISTERED
PROFESSIONAL
LAND SURVEYOR

Kenneth A. Lind

OREGON
JULY 19, 1994
KENNETH A. LIND
2672

Renews: 12-31-14