


CERTIFIED RECORD OF LAND CORNER MONUMENTATION

History of original corner establishment:

Z-25

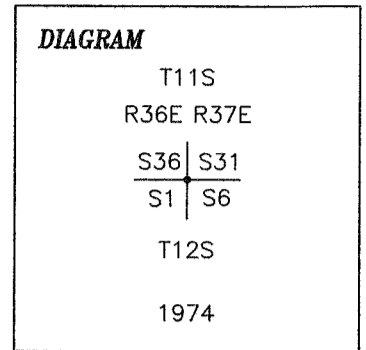

Description of corner evidence found:

Continued from Sheet 1

From which remnants of William R. Wells bearing trees:
 A Ponderosa Pine 11" in diameter bears N20¼°E, 54.6' with visible scribing.
 A 3' tall Ponderosa Pine snag bears S79°E, 37.0' with visible scribing.
 A 4' tall Ponderosa Pine snag bears N22 3/4°W, 20.3' with visible scribing.

Description of monument and accessories I established to perpetuate the original location of this corner:

New bearing trees established:

A Ponderosa Pine 8" in diameter bears S72°E, 52.2' scribed T12S R37E S6 BT.
 A Ponderosa Pine 13" in diameter bears N10°W, 44.9' scribed T11S R36E S36 BT.

Set aluminum fence post 7.9' to North with 54-2 sign.

Distance to new bearing trees measured to 60d spike in right side center. Bearing trees have brass disk stamped PLS 2672 nailed between the B and T on lower face. Bearing trees have 54-3 and 54-9 signs, a 6" red painted band, and bearing tree faces painted red.

Geodetic Coordinates (NAD83):

N 44°33'35.3"
 W 118°13'54.9"

Geodetic coordinates were obtained from a Garmin recreational grade GPS receiver.

Date: May 28, 2014
 Declination: 14 1/2° E
 Witness: Joanne Frioli

REGISTERED
PROFESSIONAL
LAND SURVEYOR

Kenneth A. Lind

OREGON
JULY 19, 1994
KENNETH A. LIND
2672

Renews: 12-31-14

FILED Oct. 23, 2014
 BAKER COUNTY SURVEYOR
 SURVEY NO. 11-36-36
 11-37-156