


P-9160-2
Nov. 1964
(formerly A1-10)

UNITED STATES
DEPARTMENT OF THE INTERIOR
BUREAU OF LAND MANAGEMENT

TOWNSHIP DIAGRAM

SCALE: 1 INCH = 1 MILE

TOWNSHIP 11 South, RANGE 37 East, Willamette MER.
STATE Oregon

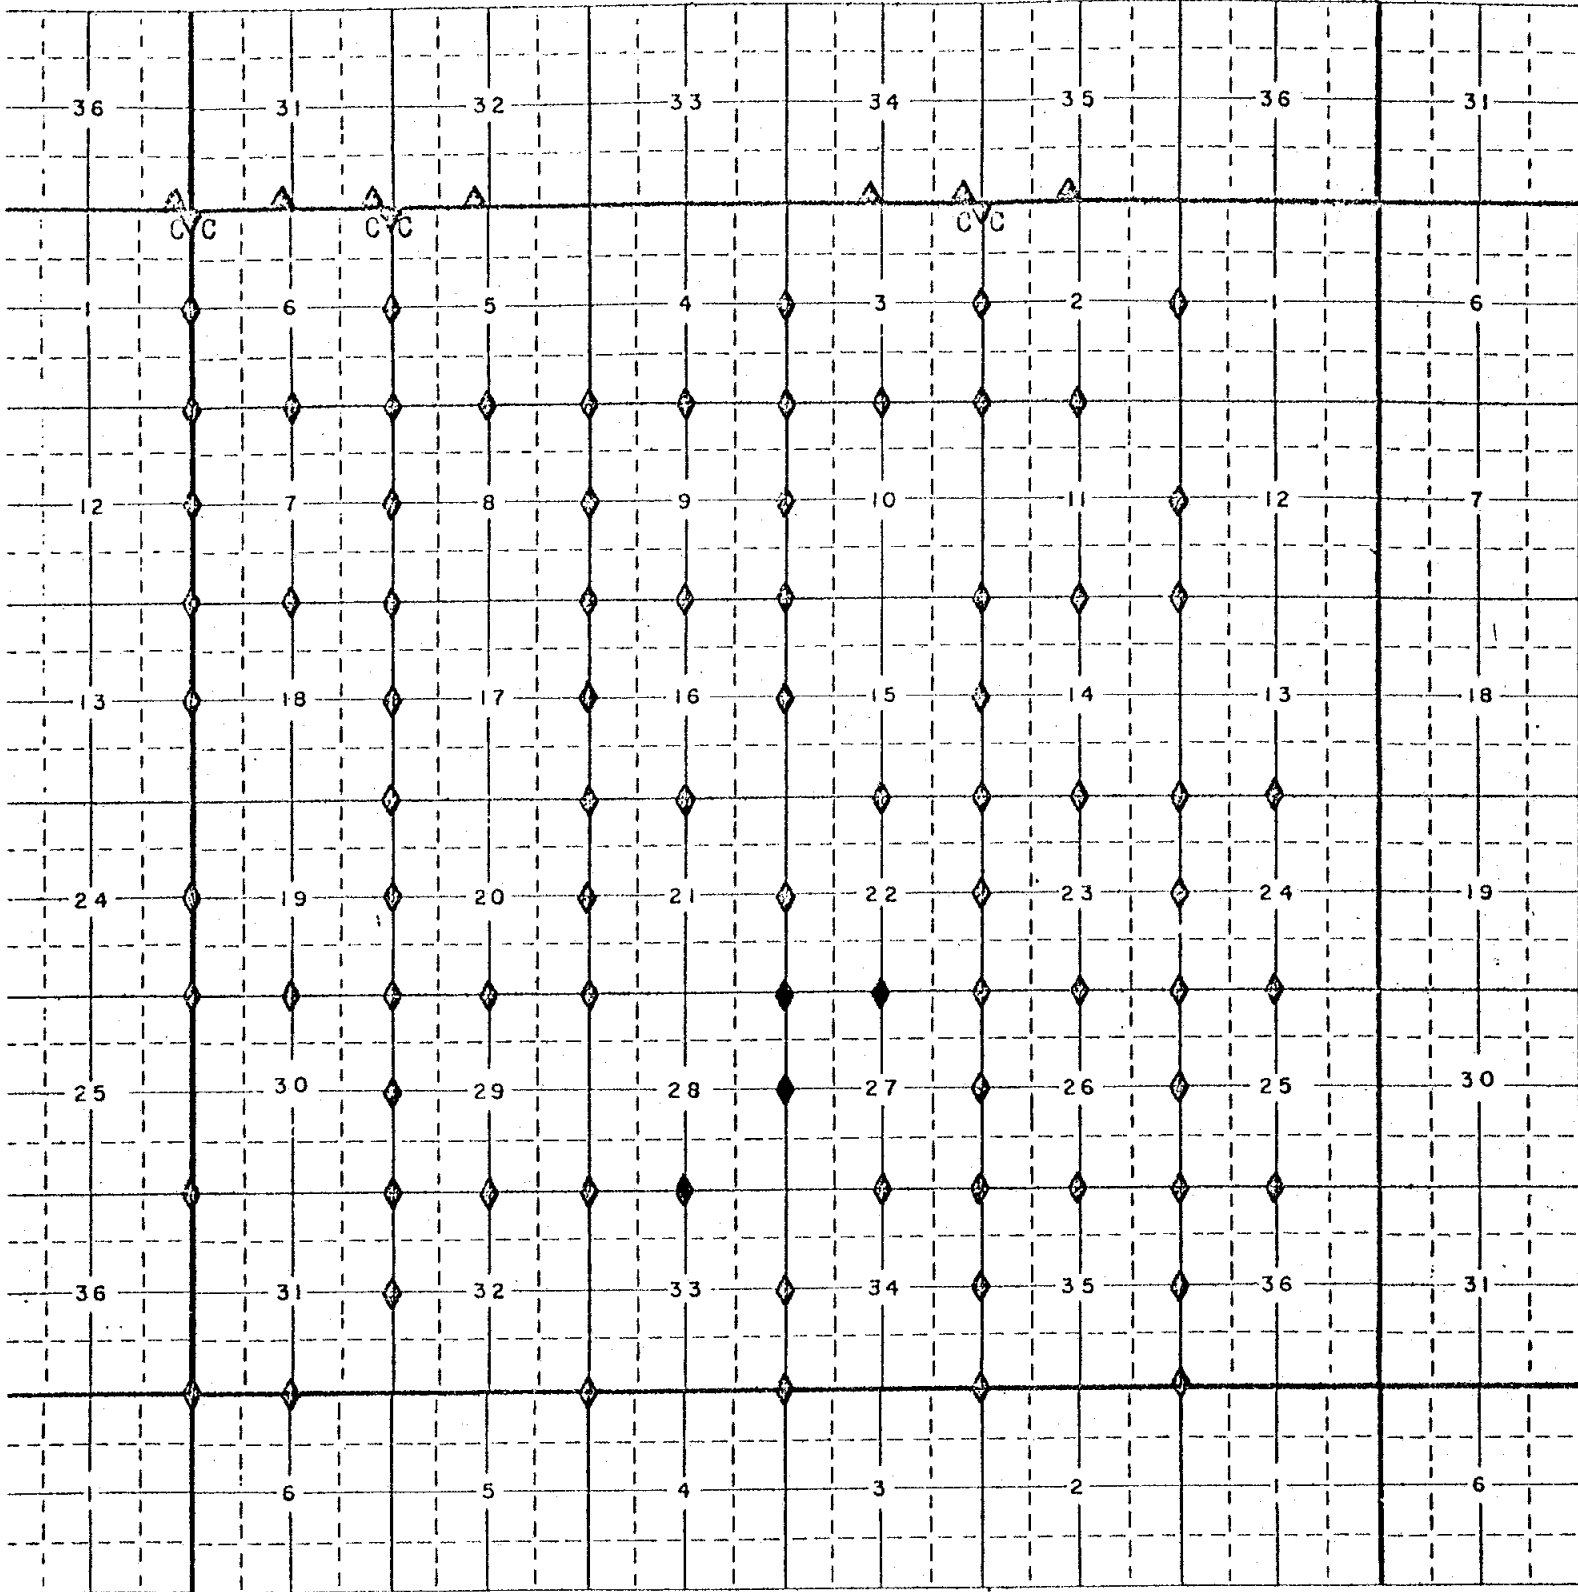

Baker County

Baker District

Wallowa-Whitman National Forest, Region 6

♦ Corners Remonumented

Nov. 18, 1974

11-31-1