


CERTIFIED RECORD OF LAND CORNER MONUMENTATION

History of original corner establishment:

Corner established this survey

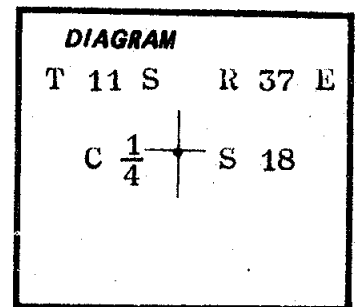

Description of corner evidence found:

Description of monument and accessories I established to perpetuate the original location of this corner:

Set a 2½ inch brass cap on a 2 inch iron pipe 31 inches long, 6 inches below jeep trail surface with a 6 ft. steel fence post alongside with signs 54-9 and 54-2 attached.

New bearing trees:

A pine, 8" diam. bears N. 09° 30' E., 43.0 ft. dist. marked C¼ S 18 BT.
A pine, 6" diam. bears N. 72° W., 60.9 ft. dist. marked C¼ S 18 BT.

Both BT have a sign 54-3 attached 6 inches below a 6 inch band of red paint and a brass washer marked LS 1206 nailed flush with BT blaze.



Brass cap marked thus:

T 11 S R 37 E

C $\frac{1}{4}$ + S 18

1978

ORLS 1206

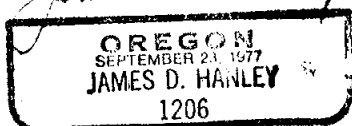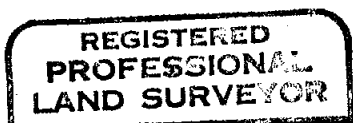

I hereby certify the above corner monument was correctly established on June 9, 1978, witnessed by B. Hanley, R. Spivey, and C. Race.

Office of..... County Surveyor..... County of..... Baker
State of..... Oregon..... I hereby certify that the within instrument was filed in this office
for record on the..... day of....., 19.....
..... by
(COUNTY OFFICIAL) (DEPUTY)

Form R6-7100-57 (9/71)

☆ GPO - 798-276

FILED 6-30-78

BAKER COUNTY SURVEYOR

FILE NO 11-37-2