


CERTIFIED RECORD OF LAND CORNER MONUMENTATION

History of original corner establishment:

Corner established this survey.

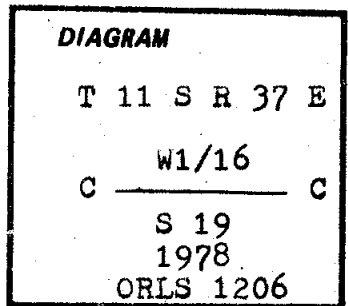

Description of corner evidence found:

Description of monument and accessories | established to perpetuate the original location of this corner:



Set a 2½ inch brass cap on a 2 inch iron pipe, 31 inches long, 26 inches in the ground with a 6 foot steel fence post alongside with signs 54-9 and 54-2 attached.

New bearing trees:

A juniper, 7 ins diam bears S 06° W., 58.4 ft dist mkd W 1/16 S 19 BT
A juniper, 14 ins diam bears S 59° W., 94.6 ft dist mkd W 1/16 S 19 BT

Each BT has a sign 54-3 attached 6 inches below a band of red paint and has a brass washer marked LS 1206 nailed flush with BT blaze.

Brass cap marked thus: T 11 S R 37 E
W 1/16
C ————— C
S 19
1978
ORLS 1206

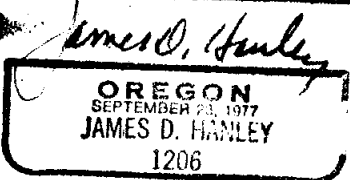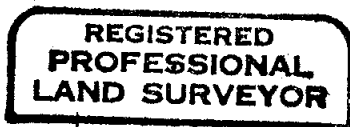

I hereby certify the above corner monument was correctly established on June 1, 1978 witnessed by B. Hanley, R. Spivey, and C. Race.

Office of.....County Surveyor.....County of. Baker
State of..Oregon....., I hereby certify that the within instrument was filed in this office
for record on the..... day of....., 19.....
..... by
(COUNTY OFFICIAL) (DEPUTY)

Form R6-7100-57 (9/71)

☆ GPO - 798-276

FILED 6-30-78
BAKER COUNTY SURVEYOR
SURVEY NO. 11-37-4