


CERTIFIED RECORD OF LAND CORNER MONUMENTATION

History of original corner establishment:

Corner established this survey.

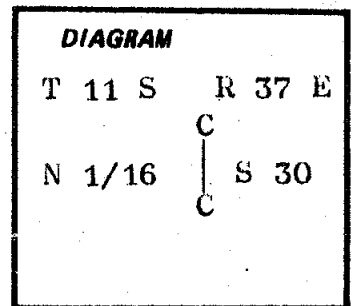

Description of corner evidence found:

Description of monument and accessories established to perpetuate the original location of this corner:

Set a 2½ inch brass cap on a 2 inch iron pipe, 31 inches long, 24 inches in the ground and a 6 foot steel fence post alongside with signs 54-9 and 54-2 attached.

New bearing trees:

A juniper, 8 in. diam. bears N. 27° W., 84.0 ft. dist. marked N 1/16 S 30 BT
A pine, 14 in. diam. bears N. 55° 30' E., 97.4 ft. dist. marked N 1/16 S 30 BT.



Both BT have a sign 54-3 attached 6 inches below a band of red paint and have a brass washer marked LS 1206 nailed flush with BT blaze.

Brass cap marked thus:

T 11 S R 37 E

C
|
N 1/16 S 30
|
C

1978
ORLS 1206

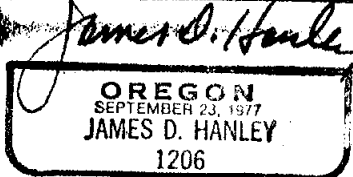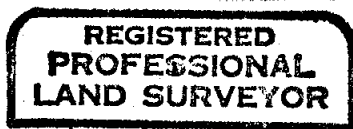

I hereby certify the above corner monument was correctly established on June 9, 1978, witnessed by B. Hanley, R. Spivey, and C. Race.

Office of County Surveyor Baker
Oregon
State of Oregon, I hereby certify that the within instrument was filed in this office
for record on the day of , 19
by
(COUNTY OFFICER) (DEPUTY)

Form R6-7100-57 (9/71)

☆ GPO - 796-276

6-30-78
11-37-6
COUNTY SURVEYOR