

CERTIFIED RECORD OF LAND CORNER MONUMENTATION

History of original corner establishment:

Corner established by Herman D. Gradon under GLO contract No. 416 dated August 19, 1881.

Surveyor's General record states:

Set a sandstone 14x10x7 ins. 9 ins. in the ground for 1/4 sec. cor. marked 1/4 on N face from which:

A pine, 36 ins. diam. bears N 10° W., 29 lks dist marked 1/4 S BT
A pine, 15 ins. diam. bears S 30° W., 36 lks dist marked 1/4 S BT

DIAGRAM

T 11 S R 37 E

$\frac{1}{4}$	$\frac{S}{S} \frac{8}{17}$
---------------	----------------------------

Description of corner evidence found:

Found a sandstone 15 ins. x 12 ins. x 8 ins. lying loose on hillside having apparently been dislodged from original position by logging equipment. Stone marked 1/4.

A pine, 24 inches diam. with fully healed blaze for section 17 BT

A rotten stump for section 8 BT

Description of monument and accessories established to perpetuate the original location of this corner.

Set a 2 1/2 inch brass cap on a 2 inch iron pipe, 31 inches long, 25 inches in the ground and buried original stone 3 feet south. A 6 foot steel fence post alongside has a sign 54-4 attached.



New bearing tree:

A pine, 7 inches diam. bears N 37°30' E, 51.9 ft. dist. marked 1/4 S 8 BT with a sign 54-3 attached 6 inches below a band of red paint and a brass washer marked LS 1206 nailed flush with BT blaze.

Brass cap marked thus: T 11 S R 37 E

$\frac{1}{4}$	$\frac{S}{S} \frac{8}{17}$
---------------	----------------------------

1978
ORLS 1206

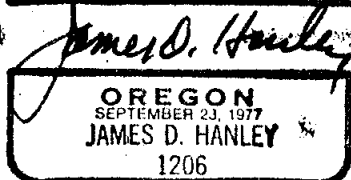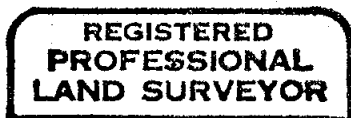

I hereby certify the above corner was correctly re-established on June 1, 1978 witnessed by T. Hanley, B. Hanley, R. Spivey, and B. Gordon.

Office of County Surveyor Baker
Oregon
State of Oregon I hereby certify that the within instrument was filed in this office
for record on the day of , 19
by
(COUNTY OFFICER) (DEPUTY)

Form R6-7100-57 (9/71)

☆ GPO : 798-276

FILED 6-30-78

BAKER COUNTY SURVEYOR
FILE NO. 11-37-7