

CERTIFIED RECORD OF LAND CORNER MONUMENTATION


History of original corner establishment:

Corner established by Eugene P. McCormack under GLO contract No. 398 dated July 2. 1881.

Surveyor's General record states:

Set a basalt stone 14x12x10 ins 10 ins in the ground for 1/4 sec cor marked 1/4 on W face from which:

- A pine, 18 ins diam bears S 30° E, 48 lks dist marked 1/4 S BT
- A pine, 24 ins diam bears N 45° W, 60 lks dist marked 1/4 S BT

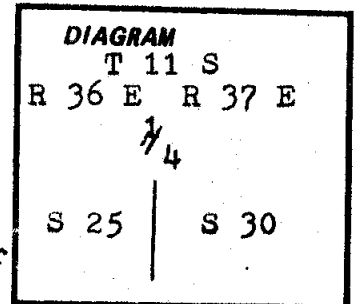

Description of corner evidence found:

None

Description of monument and accessories established to perpetuate the original location of this corner:

Set a 2 1/2 inch brass cap on a 2 inch iron pipe, 31 inches long, 25 inches in the ground with a 6 foot steel fence post alongside with a sign 54-4 attached from which:



A pine, 24 ins diam bears N 36°30' W, 165.5 ft dist marked 1/4 S 25 BT with a sign 54-3 attached 6 inches below a band of red paint and a brass washer marked LS 1206 nailed flush with BT blaze.

There being no other trees available I set a 2 1/2 inch brass cap on a 2 inch iron pipe, 31 inches long, 22 inches in the ground which bears N 01°42'45" E, 48.73 ft dist marked thus:

T 11 S
R 36 E R 37 E
R 36 M
1/4
S 25 48.73 S 30
1978
ORLS 1206

Corner monument marked thus:

T 11 S
R 36 E R 37 E
1/4
S 25 S 30
1978
ORLS 1206

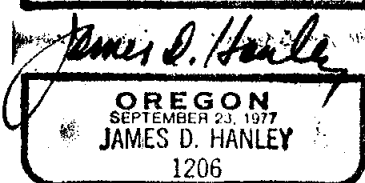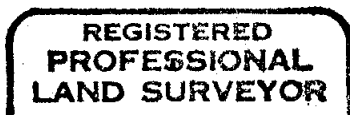

I hereby certify the above corner was correctly re-established on June 17, 1978 witnessed by B. Hanley, R. Spivey and C. Race.

Office of County Surveyor _____ County of Baker
 State of Oregon I hereby certify that the within instrument was filed in this office
 for record on the _____ day of _____, 19____
 _____ by _____
 (COUNTY OFFICIAL) (DEPUTY)

Form R6-7100-57 (9/71)

☆ GPO: 798-276

FILED 6-30-78

BAKER COUNTY SURVEYOR
 SURVEY NO. 11-37-8