


CERTIFIED RECORD OF LAND CORNER MONUMENTATION

History of original corner establishment:

Corner established by Eugene P. McCormack under G. L. O. Contract No. 398 dated July 2, 1881.

Surveyor's General record states:

Set a basalt stone 16 ins. x 14 ins. x 8 ins., 11 inches in the ground for corner to Secs. 13, 18, 19 and 24 marked with 3 notches on the North and South edges from which

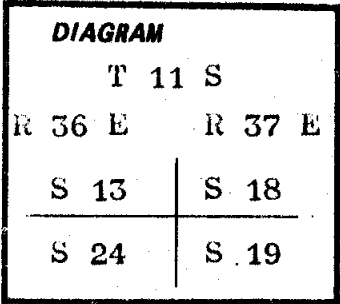

- A pine, 20 ins. diam. bears N 30° E 82 lks. dist. mkd T 11 S R 37 E S 18 BT
- A pine, 24 ins. diam. bears S 45° E 90 lks. dist. mkd T 11 S R 37 E S 19 BT
- A pine, 22 ins. diam. bears S 50° W 79 lks. dist. mkd T 11 S R 36 E S 24 BT
- A pine, 18 ins. diam. bears N 60° W 75 lks. dist. mkd T 11 S R 36 E S 13 BT

Description of corner evidence found:

Found Section 18 and 19 bearing trees with full scribing in open blazes. Section 13 BT is a pine windfall with full scribes and Section 24 BT is a stump sawed at 24 inches with BT visible and tree lying alongside with full scribes.

The Surveyor's General record notes to this corner do not agree with the trees found and the proportioned corner location appears to be the locus of the original bearing trees.

Description of monument and accessories | established to perpetuate the original location of this corner:

Set a 2½" brass cap on a 2" iron pipe 31 inches long, 26 inches in the ground with a 6 foot steel fence post alongside with a sign 54-4 attached.

New bearing trees:


- A pine, 10 inches diam. bears S. 21° W., 69.4 ft. dist. marked T 11 S R 36 E S 24 BT.
- A pine, 23 inches diam. bears N. 61° W., 99.2 ft. dist. marked T 11 S R 36 E S 24 BT.

Original bearing trees:


- A pine, 20 inches diam. bears S. 63° E., 69.5 ft. dist. marked T 11 S R 37 E S 19 BT.
- A juniper, 11 inches diam. bears N. 54° E., 105.4 ft. dist. marked T 11 S R 37 E S 18 BT.

Each BT has a sign 54-3 attached 6 inches below a band of red paint and has a brass washer marked LS 1206 nailed flush with BT blaze.

Brass cap marked thus:

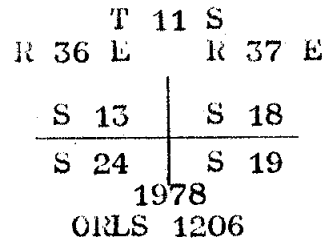

I hereby certify the corner monument was correctly established on June 1, 1978 wit. by B. Hanley, R. Spivey and C. Race.

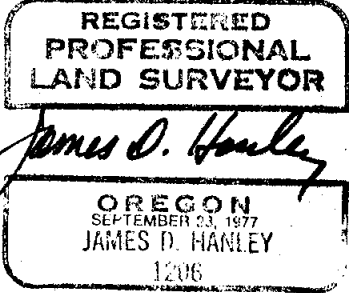

Office of.....County Surveyor..... County of..... Baker
State of.....Oregon..... I hereby certify that the within instrument was filed in this office
for record on the..... day of....., 19.....
..... by.....
(COUNTY OFFICIAL) (DEPUTY)