

CERTIFIED RECORD OF LAND CORNER MONUMENTATION

History of original corner establishment:

Corner established by Herman D. Graddon under GLO contract No. 416 dated August 19, 1881.

Surveyor's General records state:

Set a basalt stone 12x10x6 ins., 8 ins. in the ground for 1/4 sec. cor. marked 1/4 on W. face; from which

A quaking aspen 3 ins. diam. bears S 30 E , 11 lks dist. marked 1/4 S BT

An alder 7 ins diam. bears West 33 lks. dist. marked 1/4 S BT

DIAGRAM

T 11 S R 37 E

1/4

S 29 | S 28

Description of corner evidence found:

None

Description of monument and accessories I established to perpetuate the original location of this corner:

Set a 2 1/2 inch brass cap on a 2 inch iron pipe, 31 inches long, 27 inches in the ground with a 6 foot steel fence post alongside with a sign 54-4 attached.



New bearing trees:

A pine 12 ins. diam. bears N 45° W, 10.8 ft. dist. marked 1/4 S 29 BT
A pine 7 ins. diam. bears N 50° E, 11.5 ft. dist. marked 1/4 S 28 BT

Both BT'S have a sign 54-3 attached 6 inches below a band of red paint and have a brass washer marked LS 1206 nailed flush with BT blaze.

Brass cap marked thus:

T 11 S R 37 E
1/4
S 29 | S 28
1978
ORLS 1206

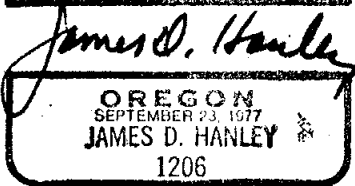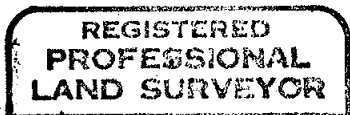

I hereby certify the above corner monument was correctly established on June 14, 1978, witnessed by T. Hanley, R. McKim, and T. Fisk.

Office of..... County Surveyor..... County of..... Baker
State of..... Oregon....., I hereby certify that the within instrument was filed in this office for record on the..... day of....., 19.....
..... by
(COUNTY OFFICIAL) (DEPUTY)

Form R6-7100-57 (9/71)

☆ GPO : 798-276

FILED 6-30-78
BAKER COUNTY SURVEYOR
SURVEY NO. 11-37-10