


CERTIFIED RECORD OF LAND CORNER MONUMENTATION

History of original corner establishment:

Corner established this survey.

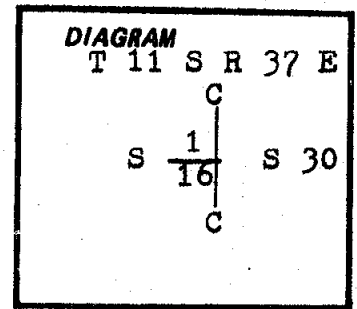

Description of corner evidence found:

Description of monument and accessories I established to perpetuate the original location of this corner:




Set a 2 1/4 inch brass cap on a 2 inch iron pipe, 31 inches long, 23 inches in the ground to bedrock with a surrounding dirt and rock mound and a 6 foot steel fence post alongside with a sign 54-9 and 54-2 attached, from which

New bearing trees:

A fir, 15 ins diam bears N 73°30' W, 19.9 ft dist marked 1/16 S 30 BT
A pine, 13 ins diam bears N 56° E, 43.9 ft dist marked 1/16 S 30 BT

Each BT has a sign 54-3 attached 6 inches below a band of red paint and has a brass washer marked LS 1206 nailed flush with BT blaze.

Brass cap marked thus: T 11 S R 37 E

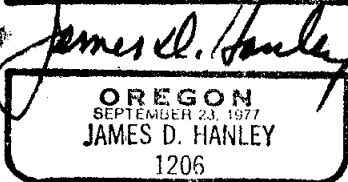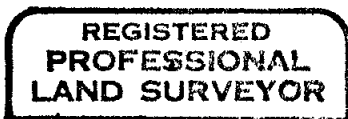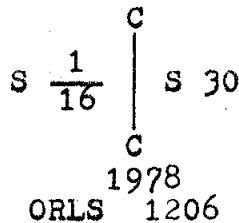

I hereby certify the above corner monument was correctly established on June 12, 1978 witnessed by T. Hanley, R. McKim and T. Fisk.

Office of... County Surveyor ... County of... Baker ...
State of... Oregon ... I hereby certify that the within instrument was filed in this office
for record on the... day of... , 19...
by...
(COUNTY OFFICIAL) (DEPUTY)

Form R6-7100-57 (9/71)

☆ GPO - 798-276

FILED 6-30-78
BAKER COUNTY SURVEYOR
SURVEY NO. 11-37-20